

Marion
 C 2007
 7/11/77

MISSISSIPPI
 BOARD OF WATER COMMISSIONERS
 416 North State Street
 Jackson, Mississippi 39201

WATER WELL DRILLERS LOG

July 11 1977 Ginn Well Service Marion
 date well completed firm name county well located

LANDOWNER:
 Mr. J. O. Cagle
 Keys Ave, Columbia
 (mailing address) Miss

description of formations encountered	from	to
Top Soil	0	1
Clay	1	14
Chert sand	14	22
Chalk	22	26
Sand	26	120

WELL LOCATION:
 sec. 19 T 5 N R. 18 E
5 miles NE of Gass
 (distance) (direction) (nearest town)

WELL PURPOSE: Home
 (home, irrigation, municipal, industrial)

- WELL COMPLETION DATA:
- (1) diameter (inches) 2"
 - (2) total depth (feet) 120 ft.
 - (3) static water level (feet) 55 below above top of ground.
 - (4) casing Plaster, 110 ft.
 (material) (depth)
2" If telescope see back.
 (size)
 - (5) screen 10 ft., 110 ft.
 (length) (depth to top)
2", Plaster
 (size) (material)
 - (6) pump 1 10
 (HP) (yield gpm)
Elec
 (type power)
 - (7) electric log No
 (yes or no)
- (organization running log)
- (8) how well bottom plugged B. W. Value


DRILLERS REMARKS:

RECEIVED
 DEC 16 1977

MISS. BD. OF WATER COMM

If well telescopes please sketch and show depths.

GROUND LEVEL

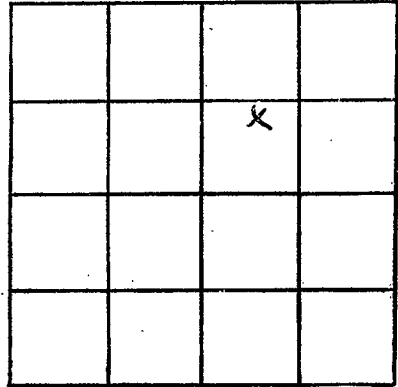

SECTION 19

Please indicate well location X.

ADDITIONAL INFORMATION

If more than one screen,
show locations of each on sketch.