

MARION
 C 2008
 7/5/77

MISSISSIPPI
 BOARD OF WATER COMMISSIONERS
 416 North State Street
 Jackson, Mississippi 39201

WATER WELL DRILLERS LOG

July 5 1977 date well completed
 77 Linn Well Service MARION firm name county well located

LANDOWNER:
 Mr. J. B. Luy
 Rt. 4 Box 495 Columbia, Miss.
 (mailing address)

description of formations encountered	from	to
Top Soil	0	2
Clay	2	12
Sand	12	84
Chnk.	84	131
SAND	131	180

WELL LOCATION:
 sec. 32 T. 4 N. R. 18 E.
 3 5 S. miles NE of Boss.
 (distance) (direction) (nearest town)

WELL PURPOSE: Home
 (home, irrigation, municipal, industrial)

- WELL COMPLETION DATA:
- (1) diameter (inches) 2"
 - (2) total depth (feet) 180 ft.
 - (3) static water level (feet) 21 ft. below top of ground.
 - (4) casing Plastic, 170 (material) (depth)
 2" (size) if telescope see back.
 - (5) screen 10 ft. 170 (length) (depth to top)
 2" Plastic (size) (material)
 - (6) pump 1 (HP) 10 (yield gpm)
 Elec (type power)
 - (7) electric log No (yes or no)

(organization running log)
 (8) how well bottom plugged
 B.W. Valve


DRILLERS REMARKS:

RECEIVED
 DEC 16 1977

MISS. BD. OF WATER COMM.

If well telescopes please sketch and show depths.

GROUND LEVEL

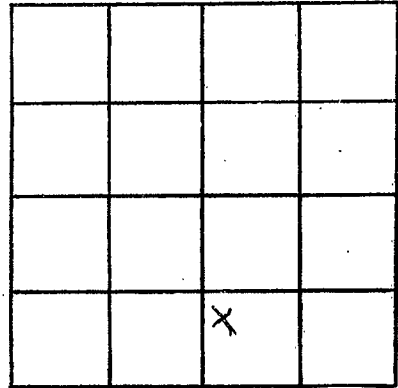

SECTION 32

Please indicate well location X.

ADDITIONAL INFORMATION

If more than one screen, show locations of each on sketch.