

Marion
C. 2009
10-9-79

MISSISSIPPI
BOARD OF WATER COMMISSIONERS
416 North State Street
Jackson, Mississippi 39201

WATER WELL DRILLERS LOG

10-9-79 19 TOM GRIFFITH Marion
date well completed firm name county well located

LANDOWNER:
Rodny Robertson
Rt. 7 Columbia
(mailing address)

description of formations encountered	from	to
<u>TOP soil</u>	<u>0</u>	<u>1</u>
<u>Chalk</u>	<u>1</u>	<u>45</u>
<u>Sand</u>	<u>45</u>	<u>60</u>
<u>Chalk</u>	<u>60</u>	<u>170</u>
<u>Sand</u>	<u>170</u>	<u>225</u>

WELL LOCATION:
sec. 16 T 5 N R 18 E
S
1 miles West of Bunker Hill
(distance) (direction) (nearest town)

WELL PURPOSE: Home
(home, irrigation, municipal, industrial)

- WELL COMPLETION DATA:
- (1) diameter (inches) 2"
 - (2) total depth (feet) 225'
 - (3) static water level (feet) 60' ^{below} _{above} top of ground.
 - (4) casing Plastic, 205'
(material) (depth)
2"
(size) If telescope see back.
 - (5) screen 20', 205'
(length) (depth to top)
2", Plastic
(size) (material)
 - (6) pump 1 (HP) (yield gpm)
Elect.
(type power)
 - (7) electric log NO (yes or no)
(organization running log)
 - (8) how well bottom plugged Blw. V.


DRILLERS REMARKS:

DEPT. OF NATURAL RESOURCES
BUREAU OF LAND & WATER RESOURCES

NOV 21 1979
RECEIVED

If well telescopes please sketch and show depths.

GROUND LEVEL

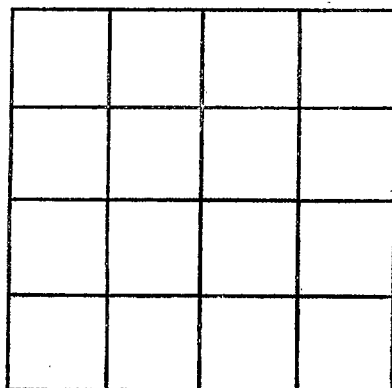

SECTION _____

Please indicate well location X.

ADDITIONAL INFORMATION

If more than one screen,
show locations of each on sketch.