

MARION
C 2011
7-28-80

MISSISSIPPI
BOARD OF WATER COMMISSIONERS
416 North State Street
Jackson, Mississippi 39201

WATER WELL DRILLERS LOG

7-28 1980 Hollinger MARION
date well completed firm name county well located

LANDOWNER: William Raymond
RTS
Columbia, MS
(mailing address)

description of formations encountered	from	to
CLAY	0	15
pea gravel	15	38

WELL LOCATION:
sec. 16 T. 5(N) S R. 18 E
2 miles W of Burkhill
(distance) (direction) (nearest town)

WELL PURPOSE:
(home, irrigation, municipal, industrial)


WELL COMPLETION DATA:
(1) diameter (inches) 2
(2) total depth (feet) 38
(3) static water level (feet) 10 below top of ground.
(4) casing PVC 33 (material) (depth)
If telescope see back.
(size)
(5) screen 5 33 (length) (depth to top)
2 PVC (size) (material)
(6) pump 1/2 12 (HP) (yield gpm)
elect (type power)
(7) electric log (yes or no)
(organization running log)

(8) how well bottom plugged sand SHARK
DRILLERS REMARKS: Good well

DEPT. OF NATURAL RESOURCES
BUREAU OF LAND & WATER RESOURCES
OCT 20 1980
RECEIVED

If well telescopes please sketch and show depths.

GROUND LEVEL

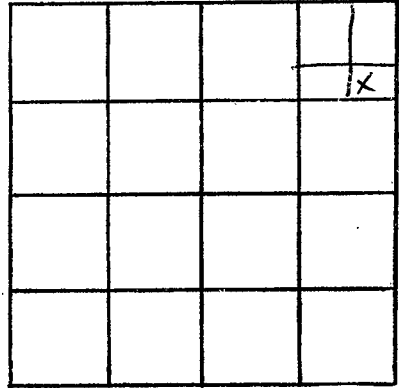

SECTION 16

Please indicate well location X.

ADDITIONAL INFORMATION

If more than one screen,
show locations of each on sketch.