

Marion  
C 2012  
4-18-81

MISSISSIPPI  
BOARD OF WATER COMMISSIONERS  
416 North State Street  
Jackson, Mississippi 39201

WATER WELL DRILLERS LOG

4-18 1981 Hollinger Marion  
date well completed firm name county well located

LANDOWNER: Ousterik Smith  
RT 7  
Columbia, MS  
(mailing address)

description of formations encountered	from	to
Red clay	0	20
sand, gravel	20	120
pea gravel	120	135

WELL LOCATION:  
sec. 4 T 50 N R 18 E  
S W  
5 1/2 miles NW of Blount  
(distance) (direction) (nearest town)

WELL PURPOSE: Home  
(home, irrigation, municipal, industrial)

- WELL COMPLETION DATA:
- (1) diameter (inches) 2"
  - (2) total depth (feet) 135
  - (3) static water level (feet) 90 below above  
top of ground.
  - (4) casing pvc 130  
(material) (depth)  
(size) if telescope see back.
  - (5) screen 5 130  
(length) (depth to top)  
2 pvc  
(size) (material)
  - (6) pump 1 6  
(HP) (yield gpm)  
elect  
(type power)
  - (7) electric log \_\_\_\_\_  
(yes or no)

DEPT. OF NATURAL RESOURCES  
BUREAU OF LAND & WATER RESOURCES

(organization running log)  
(8) how well bottom plugged sand  
SHOCK


MAY 13 1981

DRILLERS REMARKS: good well

RECEIVED

If well telescopes please sketch and show depths.

GROUND LEVEL

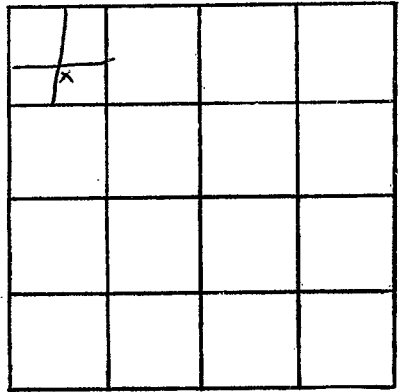

SECTION 4

Please indicate well location X.

ADDITIONAL INFORMATION

Lined area for additional information.

If more than one screen, show locations of each on sketch.