

MISSISSIPPI DEPARTMENT OF NATURAL RESOURCES

Bureau of Land and Water Resources

Southport Mall

P.O. Box 10631

Jackson, Mississippi 39209

WATER WELL DRILLERS LOG

Marion
C
2013

4/25 1984 Braden Pump & Well Serv, Inc. Marion
 date well completed firm name county well located

LANDOWNER:	description of formations encountered	from	to
<u>Rodney Robertson</u>	<u>sand</u>	<u>0</u>	<u>20</u>
<u>Rt. 4, Box 371 B</u>	<u>sand + clay</u>	<u>20</u>	<u>80</u>
<u>Columer, Ms. 39429</u>	<u>clay</u>	<u>80</u>	<u>300</u>
(mailing address)	<u>clay + sand</u>	<u>300</u>	<u>340</u>
	<u>sand</u>	<u>340</u>	<u>360</u>

WELL LOCATION:
 sec. 19 T. 5 N. R. 18 E.
3 miles N.E. of Joss
 (distance) (direction) (nearest town)

WELL PURPOSE: home
 (home, irrigation, municipal, industrial)

- WELL COMPLETION DATA:
- (1) diameter (inches) 4x2
 - (2) total depth (feet) 360ft.
 - (3) static water level (feet) 145' below top of ground.
 - (4) casing PVC, 345',
 (material) (depth)
4x2" if telescope see back.
 (size)
 - (5) screen 10', 345'
 (length) (depth to top)
2", PVC underbar
 (size) (material)
 - (6) pump 1, 15
 (HP) (yield gpm)
230V
 (type power)
 - (7) electric log no
 (yes or no)
- (organization running log)

(8) how well bottom plugged PVC
Abundant
 DRILLERS REMARKS: 5'
tailpipe


DEPT. OF NATURAL RESOURCES
 BUREAU OF LAND & WATER RESOURCES

MAY 21 1984

RECEIVED

If well telescopes please sketch and show depths.

GROUND LEVEL

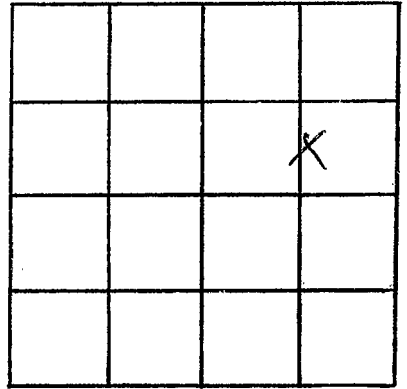

SECTION 19

Please indicate well location X.

ADDITIONAL INFORMATION

If more than one screen,
show locations of each on sketch.