

MISSISSIPPI DEPARTMENT OF NATURAL RESOURCES

Bureau of Land and Water Resources

Southport Mall

P.O. Box 10631

Jackson, Mississippi 39209

WATER WELL DRILLERS LOG

Marion  
C 0015

Oct 22-85 19  
date well completed

Walburn Wellbys  
firm name

Marion  
county well located

LANDOWNER: Richard  
Honlevander  
3913 Lyndell Dr  
Chalmette La  
(mailing address)

description of formations encountered	from	to
<u>Red Clay</u>	<u>0</u>	<u>14</u>
<u>sand</u>	<u>14</u>	<u>47</u>
<u>gray clay</u>	<u>47</u>	<u>60</u>
<u>sand</u>	<u>60</u>	<u>72</u>
<u>Black Clay</u>	<u>72</u>	<u>105</u>
<u>and fragment</u>	<u>105</u>	<u>121</u>

WELL LOCATION:  
sec 20 T 5 N R 18 E  
13 miles NE of Columbia  
(distance) (direction) (nearest town)

WELL PURPOSE: Home  
(home, irrigation, municipal, industrial)

WELL COMPLETION DATA: Oct 22

- (1) diameter (inches) 2"
- (2) total depth (feet) 121'
- (3) static water level (feet) 105 below surface top of ground.
- (4) casing pvc 1 1/2"  
(material) (depth)

(size) if telescope see back.


- (5) screen 10' 1 1/2"  
(length) (depth to top)
- 10 pvc  
(size) (material)
- (6) pump 1/2 9  
(HP) (yield gpm)
- Electric  
(type power)

(7) electric log (yes or no)

(organization running log)

(8) how well bottom plugged sand  
shells

DRILLERS REMARKS:

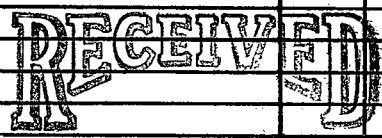


NOV - 1 1985

Department of Natural Resources  
Bureau of Land & Water Resources

If well telescopes please sketch and show depths.

GROUND LEVEL

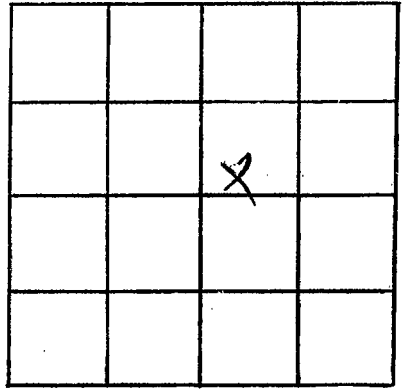

SECTION \_\_\_\_\_

Please indicate well location X.

ADDITIONAL INFORMATION

If more than one screen,  
show locations of each on sketch.