

MISSISSIPPI DEPARTMENT OF NATURAL RESOURCES

Bureau of Land and Water Resources

Southport Mall

P.O. Box 10631

Jackson, Mississippi 39209

WATER WELL DRILLERS LOG

Marion
C 2016

3-12 1988
date well completed

Hollinger Well
firm name

Marion
county well located

LANDOWNER: <u>Hennetta Walker</u>	description of formations encountered	from	to
<u>RHS</u>			
<u>Columbia, MS.</u> (mailing address)	<u>Clay</u>	<u>0</u>	<u>20</u>
WELL LOCATION:	<u>dissect, sand gravel</u>	<u>21</u>	<u>30</u>
sec. <u>3</u> T <u>5</u> N R <u>18</u> E	<u>Chalk</u>	<u>30</u>	<u>64</u>
<u>4</u> miles <u>N</u> of <u>Starks</u> (distance) (direction) (nearest town)	<u>Coarse sand</u>	<u>64</u>	<u>80</u>
WELL PURPOSE: (home, irrigation, municipal, industrial)			
WELL COMPLETION DATA:			
(1) diameter (inches) <u>4</u>			
(2) total depth (feet) <u>80</u>			
(3) static water level (feet) <u>25</u> <u>below</u> top of ground. <u>above</u>			
(4) casing <u>PVC</u> , <u>70</u> (material) (depth) <u>if telescope see back.</u> (size)			
(5) screen <u>10</u> , <u>70</u> (length) (depth to top)			
(6) pump <u>4</u> , <u>PVC</u> (size) (material)			
(7) pump <u>1/2</u> , <u>12</u> (HP) (yield gpm)			
<u>elect</u> (type power)			
(8) electric log (yes or no)			
(organization running log)			
(8) how well bottom plugged <u>sand</u> <u>shark</u>			
DRILLERS REMARKS: <u>Very good well</u>			


RECEIVED

MAY 19 1988

Department of Natural Resources
Bureau of Land & Water Resources

If well telescopes please sketch and show depths.

GROUND LEVEL

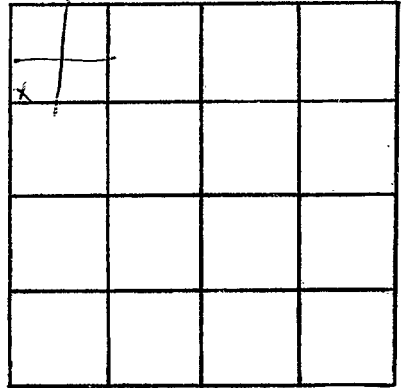

SECTION _____

Please indicate well location X.

ADDITIONAL INFORMATION

If more than one screen, show locations of each on sketch.