

~~C 5 D 4~~
2-4-63

WATER WELL DRILLERS LOG

Date: 2-4, 1963, Driller: F. B. SHERPARD County Marion
(Name)


(1) Owner of Land: J. C. CRAWLEY
(Name)
Bunker Hill
(Address)
19 5-17
(2) Location: 1/4, 1/4, Sec. T. R.
1.3 miles N.E., of COLUMBIA
(distance) (direction) (Nearest Town)
MISS.
(3) Topography: (Hilly) (Flat) (Level)
(4) Purpose of Well: Domestic
(Domestic Irrigation
Municipal, Industrial, Other)

Description & Color of Materials Sand, Clay, Red Clay, Shell, etc.	Thick- ness Feet	Depth Feet
<u>RED SANDY CLAY</u>		<u>20</u>
		<u>40</u>
		<u>60</u>
<u>PIEA GRAY</u>		<u>80</u>
		<u>100</u>

CODED

Information upon completion of well:

(1) Diameter 2 inches.
(2) Total Depth 84 feet.
(3) Water Level 53' feet below top of ground.
(4) Cased to _____, Size _____
(5) Screen: Size 2", Length 5'
(6) Were any formations sealed against pollution?
_____ yes, _____ no.

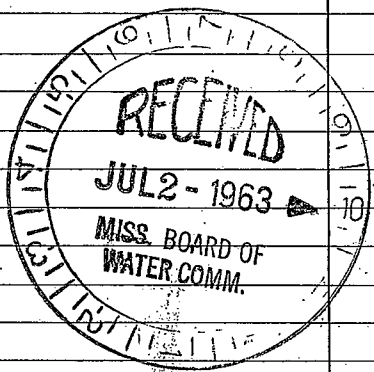

If YES depth of formation _____
Why _____
Drillers Remarks: _____

Well No.

(Use Back Side)

