

MARION
215
12-30-61

WATER WELL DRILLERS LOG

Date: 12-30, 1961, Driller: Dean Brewer County MARION
 (Name)

(1) Owner of Land: MARENCE BENNETT
 (Name)
Rt. 1 Columbia, Miss.
 (Address)

(2) Location: 1/4, 1/4, Sec. 22 S17 T R
12 miles N.E. of COLUMBIA
 (distance) (direction) (Nearest Town)

(3) Topography: X
 (Hilly) (Flat) (Level)

(4) Purpose of Well: Domestic
 (Domestic Irrigation
 Municipal, Industrial, Other)

Description & Color of Materials Sand, Clay, Red Clay, Shell, etc.	Thick- ness Feet	Depth Feet
top soil	1'	1'
RED CLAY	10'	11'
FINE SAND	20'	31'
CHALK	10'	41'
SAND	15'	56'
CHALK	8'	64'
SAND + Pee GRAVEL	36'	100'
CODED		

Information upon completion of well:

(1) Diameter 2 inches.

(2) Total Depth 100 feet.

(3) Water Level 42 feet below top of ground.

(4) Cased to 95', Size 2"


(5) Screen: Size 2", Length 5'

(6) Were any formations sealed against pollution?
 yes, X no.

If YES depth of formation _____

Why _____

Drillers Remarks: _____

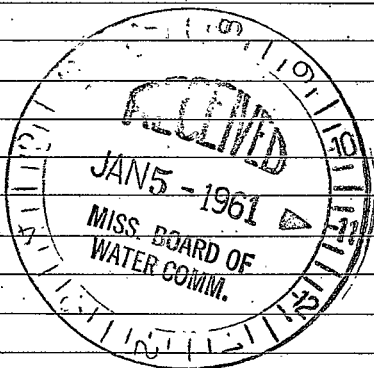

(Use Back Side)

Well No.

