

Marion Co.
 D 10
 2-69

MISSISSIPPI
 BOARD OF WATER COMMISSIONERS
 416 North State Street
 Jackson, Mississippi 39201

CODED

CODED

CODED

WATER WELL DRILLERS LOG

2-24-69 19 Desu Drives Marion
 date well completed firm name county well located

LANDOWNER:

description of formations encountered

from to

Kenny Ward
 Route 1 Columbia
 Miss (mailing address)

top soil	0-1
clay	1-25
fine sand	25-65
water sand	65-100

WELL LOCATION:

sec 23 T5 N R 17 W
 12 miles NE of Columbia
 (distance) (direction) (nearest town)

WELL PURPOSE: Home
 (home, irrigation, municipal, industrial)

WELL COMPLETION DATA:

- (1) diameter (inches) 2"
- (2) total depth (feet) 100'
- (3) static water level (feet) 65' below top of ground.
- (4) casing Plastic, 96' (material) (depth)
- if telescope see back. (size)
- (5) screen 4' (length), 96' (depth to top)
 2" (size), Plastic (material)
- (6) pump 3/4 HP Ruth Berry (HP) (yield gpm)
- (type power)
- (7) electric log (yes or no)
- (organization running log)
- (8) how well bottom plugged

CODED

CODED


MAR 3 1969

MISS. Bd. of WATER COMMISSIONERS

DRILLERS REMARKS:

If well telescopes please sketch and show depths.

GROUND LEVEL

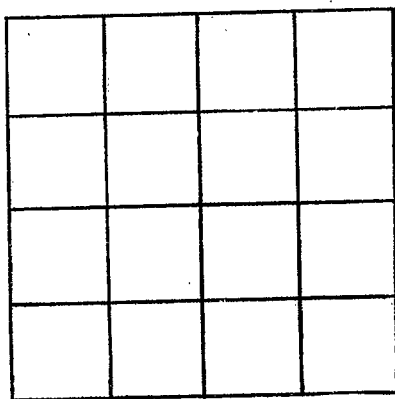

SECTION _____

Please indicate well location X.

ADDITIONAL INFORMATION

If more than one screen, show locations of each on sketch.