

MARION

D 11

WATER WELL DRILLERS LOG

CODED

Date: 6-1, 1966, Driller: E. B. SHERRARD County MARION

6-1-66

(Name)

(1) Owner of Land: BEN RUSSELL
(Name)

(Address)

(2) Location: 1/4, 1/4, Sec. 9 ^{R 17 W} _{T 5 N}

13 miles N-E, of Cal.
(distance) (direction) (Nearest Town)

(3) Topography: (Hilly) (Flat) (Level)

(4) Purpose of Well: DOMESTIC
(Domestic Irrigation, Municipal, Industrial, Other)

Description & Color of Materials
Sand, Clay, Red Clay, Shell, etc.

Thick-
ness
Feet

De
Fe

GRAY CLAY

20

SAND + SILT
HARD FIRM
GRAY + BLUE
CLAY

38

120

COARSE WHITE
+ BLACK OIL C.
+ SAND

132


Information upon completion of well:

- (1) Diameter 2 inches.
- (2) Total Depth 132 feet.
- (3) Water Level 60' feet below top of ground.
- (4) Cased to 132, Size 2"
- (5) Screen: Size 2", Length 3'
- (6) Were any formations sealed against pollution?
yes, no.

If YES depth of formation _____

Why _____

Drillers Remarks: _____

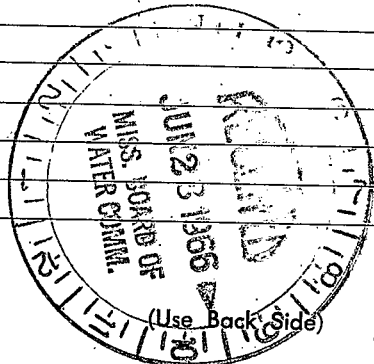

(Use Back Side)

Well No.

Retain this copy for your office files.

