

CODED

MISSISSIPPI
BOARD OF WATER COMMISSIONERS
416 North State Street
Jackson, Mississippi 39201

WATER WELL DRILLERS LOG

MARION
D 15
I- 70

JAN. 1970 E.B. Sherrard Marion
 date well completed firm name county well located

LANDOWNER: Pt. 3 - Columbia Miss. (mailing address)	description of formations encountered RIED CLAY SANDY CLAY SANDY SILT SANDY SILT	from	to
		0	30' 90' 138'
WELL LOCATION:			
sec 31 T5 N R12 E 9 miles NE of Columbia (distance) (direction) (nearest town)			
WELL PURPOSE: (home) irrigation, municipal, industrial			
WELL COMPLETION DATA:			
(1) diameter (inches) 2"			
(2) total depth (feet) 138'			
(3) static water level (feet) 95' below top of ground.			
(4) casing (material) Plastic, (depth) 138'			
2" (size) If telescope see back.			
(5) screen 3' (length) (depth to top)			
2 1/2" (size) S-S. (material)			
(6) pump 1 1/2 (HP) 8 (yield gpm)			
(type power)			
(7) electric log (yes or no) (no)			
(organization running log)			
(8) how well bottom plugged Bw			
DRILLERS REMARKS:			


CODED

FEB 5 - 1970

RD. OF
WATER COMB.

If well telescopes please sketch and show depths.

GROUND LEVEL

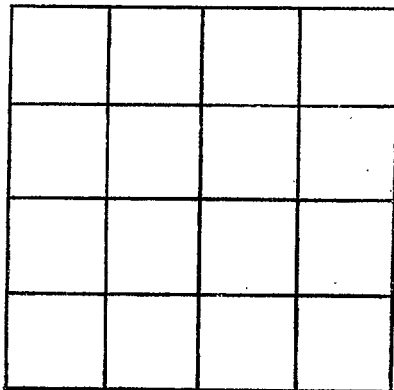

SECTION _____

Please indicate well location X.

ADDITIONAL INFORMATION

If more than one screen,
show locations of each on sketch.