

MISSISSIPPI
BOARD OF WATER COMMISSIONERS
416 North State Street
Jackson, Mississippi 39201

CODED

WATER WELL DRILLERS LOG

Marion
D 16
2-70

FEB 1970 E.B. SHERRARD MARION
date well completed firm name county well located

LANDOWNER:	description of formations encountered	from	to
<u>E.L. Cook</u>	<u>SAND & GRAVEL</u>	<u>0</u>	<u>100'</u>
<u>P.L. 3 - COLUMBIA, MISS.</u> (mailing address)			
WELL LOCATION: sec <u>22</u> T <u>5</u> <u>N</u> R <u>17</u> <u>E</u> <u>12</u> miles <u>NE</u> of <u>COLUMBIA</u> (distance) (direction) (nearest town)			
WELL PURPOSE: (<u>home</u>) irrigation, municipal, industrial			
WELL COMPLETION DATA: (1) diameter (inches) <u>2"</u> (2) total depth (feet) <u>100'</u> (3) static water level (feet) <u>32</u> <u>below</u> above top of ground. (4) casing <u>P.L.</u> , <u>100'</u> (material) (depth) <u>2"</u> if telescope see back. (size) (5) screen <u>3'</u> (length) (depth to top) <u>2 1/2"</u> , <u>S.S.</u> (size) (material) (6) pump <u>3/4</u> <u>9</u> (HP) (yield gpm) <u>E</u> (type power) (7) electric log <u>(yes or no)</u> <u>(organization running log)</u> (8) how well bottom plugged <u>BWV</u>			
DRILLERS REMARKS:			


CODED

MAR 17 1970

MISS. BD. OF
WATER COM.

If well telescopes please sketch and show depths.

GROUND LEVEL

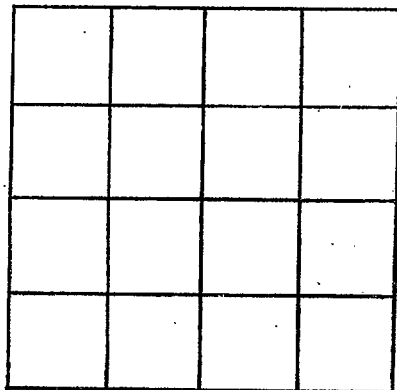

SECTION _____

Please indicate well location X.

ADDITIONAL INFORMATION

If more than one screen,
show locations of each on sketch.