

Marion
D 17
2-70

MISSISSIPPI
BOARD OF WATER COMMISSIONERS
416 North State Street
Jackson, Mississippi 39201

CODED

WATER WELL DRILLERS LOG

FEB. 1970 E.B. SHERRARD MARION
date well completed firm name county well located

LANDOWNER:
Mrs. VERA MAE WILLIAMS
Rt. 1 - COLUMBIA, Miss.
(mailing address)

description of formations encountered	from	to
RED SANDY CLAY	0	90
GRAVEL SAND	90	108
RED FIRM CLAY BASE		

WELL LOCATION:
sec. 34-T-5 S R-17 E
10 miles NE of COLUMBIA
(distance) (direction) (nearest town)

WELL PURPOSE:
(home) irrigation, municipal, industrial

- WELL COMPLETION DATA:
- (1) diameter (inches) 2"
 - (2) total depth (feet) 108
 - (3) static water level (feet) 92 below above top of ground.
 - (4) casing PL (material), 108 (depth), 2" (size) if telescope see back.
 - (5) screen 3' (length), (depth to top) 2 1/2" (size), S.S. (material)
 - (6) pump 1 1/2 (HP), 7 (yield gpm), E (type power)
 - (7) electric log (yes or no)
 - (organization running log)
 - (8) how well bottom plugged BNV

CODED


MAR 17 1970

DRILLERS REMARKS:

MISS. BD. OF WATER COMMISSIONERS

If well telescopes please sketch and show depths.

GROUND LEVEL

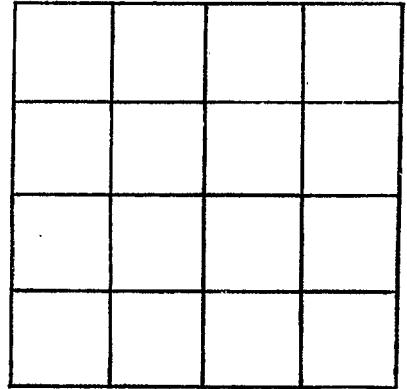

SECTION _____

Please indicate well location X.

ADDITIONAL INFORMATION

If more than one screen,
show locations of each on sketch.