

MARION
D 19
7-20-70

MISSISSIPPI
BOARD OF WATER COMMISSIONERS
416 North State Street
Jackson, Mississippi 39201

CODED

WATER WELL DRILLERS LOG

7/20 1970 STR Marion
date well completed firm name county well located

LANDOWNER: Robert R. Tolson
pt 1
Columbia, Miss.
(mailing address)

description of formations encountered	from	to
Sand & Gravel	0	12
Fine Sand	12	60
P.S. & sand	60	76
Clay B sand	76	125

WELL LOCATION:
sec 30 T 5 S R 17 E
7 miles NE of Columbia
(distance) (direction) (nearest town)

WELL PURPOSE: Home
(home, irrigation, municipal, industrial)

- WELL COMPLETION DATA:
- (1) diameter (inches) 2"
 - (2) total depth (feet) 125
 - (3) static water level (feet) 97 below top of ground.
 - (4) casing plastic, 120 (material) (depth)
2" (size) if telescope see back.
 - (5) screen 5 (length), 120 (depth to top)
2" (size), plastic (material)
 - (6) pump 1 (HP), 360 (yield gpm)
60 (type power)
 - (7) electric log (yes or no)
(organization running log)
 - (8) how well bottom plugged Value

CODED


OCT 12 1970

MISS. RD. & WATER COMM.

DRILLERS REMARKS:

If well telescopes please sketch and show depths.

GROUND LEVEL

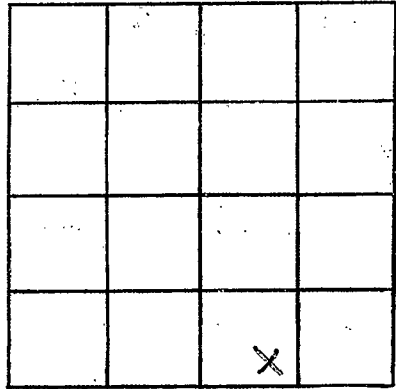

SECTION 30

Please indicate well location X.

ADDITIONAL INFORMATION

If more than one screen, show locations of each on sketch.