

MARION

D 20

9-7-70

MISSISSIPPI BOARD OF WATER COMMISSIONERS
416 North State Street
Jackson, Mississippi 39201

CODED

WATER WELL DRILLERS LOG

9/7

1970

DFR

Marion

date well completed

firm name

county well located

LANDOWNER: Hilton Rayburn

description of formations encountered

from to

Rt. 1

Columbia Miss
(mailing address)

pulled 70 ft.
1/2 gal. pipe
redrilled to 100 ft.

WELL LOCATION:

sec 22 T 5 S R 17 E
10 miles NE of Colum
(distance) (direction) (nearest town)

fine sand
CWB sand

70 88
88 101

WELL PURPOSE: Home
(home, irrigation, municipal, industrial)

WELL COMPLETION DATA:

- (1) diameter (inches) 2 in.
- (2) total depth (feet) 100 ft.
- (3) static water level (feet) 56 below above top of ground.
- (4) casing plastic, 90
(material) (depth)
2 in. If telescope see back.
(size)
- (5) screen 10 ft., 90
(length) (depth to top)
2 in., plastic
(size) (material)
- (6) pump 1 HP, 700 GPM
(HP) (yield gpm)
jet
(type power)
- (7) electric log _____
(yes or no)

(organization running log)
- (8) how well bottom plugged valve

CODED


OCT 12 1970

MISS. BD. OF
WATER COMMISSIONERS

DRILLERS REMARKS:

If well telescopes please sketch and show depths.

GROUND LEVEL

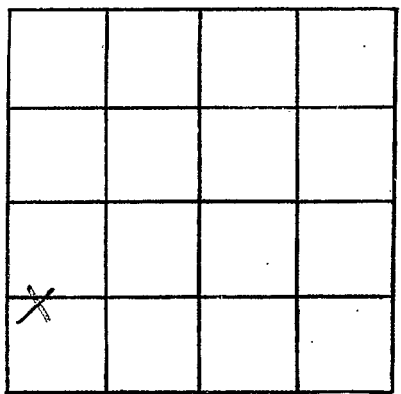

SECTION 22

Please indicate well location X.

ADDITIONAL INFORMATION

Lined area for additional information.

7

If more than one screen, show locations of each on sketch.