

MARION  
D 21  
7-70

MISSISSIPPI  
BOARD OF WATER COMMISSIONERS  
416 North State Street  
Jackson, Mississippi 39201

CODED

WATER WELL DRILLERS LOG

July 1970 ~~W.E.A.~~ E.B. SHERRARD MARION  
date well completed firm name county well located

LANDOWNER: WILLIE E. ECHOLS

description of formations encountered	from	to
	RTED SANDY CLAY MOSTLY SAND	0
COARSE SAND	60	78
PIEA GRAVEL & SAND MIXED	78	90

Rt. 3 - Box 364  
Columbia, Miss.  
(mailing address)

WELL LOCATION:  
sec. 21 T. 5 N R. 17 E  
S W  
12 miles NE of Columbia  
(distance) (direction) (nearest town)

WELL PURPOSE:  
(home, irrigation, municipal, industrial)

WELL COMPLETION DATA:

- (1) diameter (inches) 2"
- (2) total depth (feet) 90
- (3) static water level (feet) 38 below top of ground.
- (4) casing PLASTIC 85 (material) (depth)  
2" (size) if telescope see back.
- (5) screen 3' (length) (depth to top)  
2" S.S. (size) (material)
- (6) pump 3/4 (HP) 8 (yield gpm)  
E (type power)
- (7) electric log (yes or no) (no)
- (organization running log)
- (8) how well bottom plugged BWV

CODED


AUG 13 1970

DRILLERS REMARKS:

MISS. DD. OF  
WATER COMM.

If well telescopes please sketch and show depths.

GROUND LEVEL

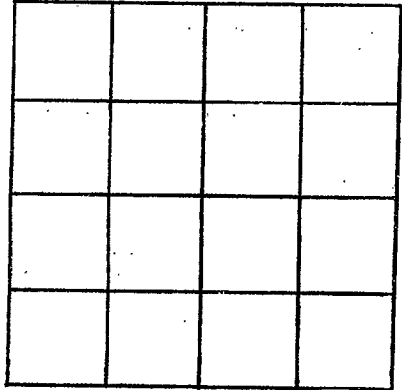

SECTION \_\_\_\_\_

Please indicate well location X.

ADDITIONAL INFORMATION

A series of horizontal lines providing space for additional information.

If more than one screen, show locations of each on sketch.