

MARION
D 24
1-71

MISSISSIPPI
BOARD OF WATER COMMISSIONERS
416 North State Street
Jackson, Mississippi 39201

CODED

WATER WELL DRILLERS LOG

JAN. 1971 E.B. SHEPARD MARION
date well completed firm name county well located

LANDOWNER:
LUKE PACE
Rt. 1 - COLUMBIA, Miss.
(mailing address)

description of formations encountered	from	to
GRAYISH BLUE CLAY	0	240
FINE SAND	240	300
COARSE SAND & GRAVEL	300	315

WELL LOCATION:
sec 25 T 5 N R 17 E
25 S W
13 miles N-E of COL.
(distance) (direction) (nearest town)

WELL PURPOSE:
(home, irrigation, municipal, industrial)

- WELL COMPLETION DATA:
- (1) diameter (inches) 3"
 - (2) total depth (feet) 315
 - (3) static water level (feet) 155 ^{below} top of ground.
 - (4) casing PLASTIC, 315, (material) (depth)
3" (size) if telescope see back.
 - (5) screen 6' (length) (depth to top)
3" (size) PL (material)
 - (6) pump 1/2 SUB A (HP) (yield gpm)
E (type power)
 - (7) electric log (yes or no)
 - (organization running log)
 - (8) how well bottom plugged B, W, V.

CODED


MAY 27 1971

MISS. BD. OF
WATER COM.

DRILLERS REMARKS:

If well telescopes please sketch and show depths.

GROUND LEVEL

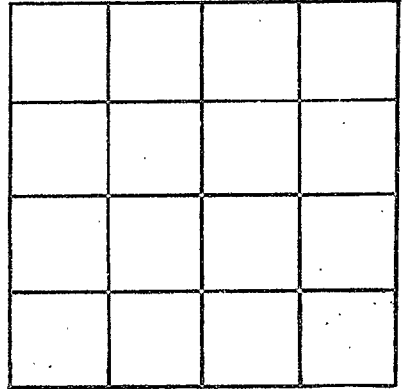

SECTION _____

Please indicate well location X.

ADDITIONAL INFORMATION

If more than one screen,
show locations of each on sketch.