

MARION
D-25
8-15-71

MISSISSIPPI
BOARD OF WATER COMMISSIONERS
416 North State Street
Jackson, Mississippi 39201

CODED

WATER WELL DRILLERS LOG

8-15 1971 Griner Drilling Service Marion
date well completed firm name county well located
Doyke

LANDOWNER: No. 1 B.B.
Bradley et al, Larco
Drilling + Exploration Corp.
(mailing address)

description of formations encountered	from	to
Top Soil	0	2
Sand + Gravel	2	95
Clay	95	440
Sand	440	470
Clay	470	510
Sand	510	570

WELL LOCATION:
sec. 28 T. 30 N. R. 19 E.
330' N + 1940' E of SW/40 SW
(distance) miles (direction) of (nearest town)

WELL PURPOSE: Oil Field
(home, irrigation, municipal, industrial)

- WELL COMPLETION DATA:
- (1) diameter (inches) 3
 - (2) total depth (feet) ~~440~~ 570
 - (3) static water level (feet) NA below above top of ground.
 - (4) casing BE 550 (material) (depth)
3 (size) if telescope see back.
 - (5) screen 20' 550 (length) (depth to top)
3 (size) Slotted PVC (material)
 - (6) pump N.A. 50-60 (HP) (yield gpm)
Air Comp. (type power)
 - (7) electric log No. (yes or no)
No. (organization running log)
 - (8) how well bottom plugged welded
Closed - Orange peel


DRILLERS REMARKS: @

SEP 2 1971

MISS. Bd. of WATER COMMS.

If well telescopes please sketch and show depths.

GROUND LEVEL

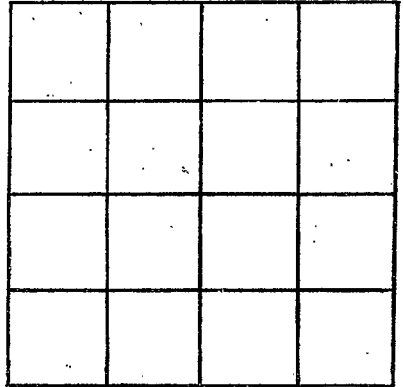

SECTION _____

Please indicate well location X.

ADDITIONAL INFORMATION

If more than one screen, show locations of each on sketch.