

MARION
D27
5-72

MISSISSIPPI
BOARD OF WATER COMMISSIONERS
416 North State Street
Jackson, Mississippi 39201

CODED

WATER WELL DRILLERS LOG

May 1972 E. B. Sheppard Marion
date well completed firm name county well located

LANDOWNER:

Ester H. Sims
Rt. 2 - Brasfield, Miss
(mailing address)

description of formations encountered

description of formations encountered	from	to
<u>FIRM GRAYISH CLAY</u>	<u>0</u>	<u>90</u>
<u>LOOSE SANDY CLAY</u>	<u>90</u>	<u>120</u>
<u>COARSE SAND & GRAVEL</u>	<u>120</u>	<u>158</u>

WELL LOCATION:

sec. 9 T. 5 S. R. 17 E.
5 1/2 miles SE of Brasfield
(distance) (direction) (nearest town)

WELL PURPOSE:

(home) irrigation, municipal, industrial

WELL COMPLETION DATA:

- (1) diameter (inches) 2"
- (2) total depth (feet) 158'
- (3) static water level (feet) 80' below above top of ground.
- (4) casing pl. 15.3'
(material) (depth)
2" if telescope see back.
(size)
- (5) screen 5' pl.
(length) (depth to top)
2" (size) (material)
- (6) pump 1 7
(HP) (yield gpm)
E.
(type power)
- (7) electric log (yes or no)
(organization running log)
- (8) how well bottom plugged BWR


CODED

JUL 28 1972

DRILLERS REMARKS:

If well telescopes please sketch and show depths.

GROUND LEVEL

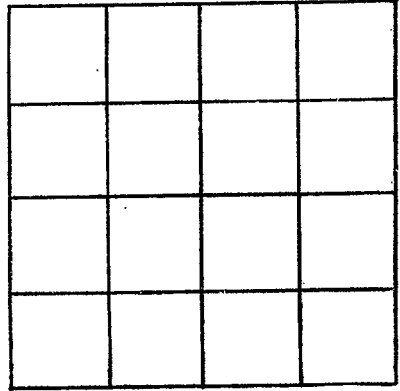

SECTION _____

Please indicate well location X.

ADDITIONAL INFORMATION

If more than one screen,
show locations of each on sketch.