

MISSISSIPPI
BOARD OF WATER COMMISSIONERS
416 North State Street
Jackson, Mississippi 39201

CODED

WATER WELL DRILLERS LOG


MARION
D28
6-9-72

6-9 1972 Greiner Water Well Drilling Marion
 date well completed firm name county well located

LANDOWNER:	description of formations encountered	from	to
Roger Hudson	Top Soil	0	1'
Route 3 Columbus (mailing address)	clay	1	20'
WELL LOCATION: sec. <u>35</u> T. <u>5</u> S. R. <u>17</u> E. <u>19</u> miles <u>N.S.</u> of <u>Columbus</u> (distance) (direction) (nearest town)	gravel	10	28'
WELL PURPOSE: <u>home</u> (home, irrigation, municipal, industrial)	sand	28	55'
WELL COMPLETION DATA: (1) diameter (inches) <u>2"</u>	gravel	55	71'
(2) total depth (feet) <u>145'</u>	fine sand	71	80'
(3) static water level (feet) <u> </u> below/above top of ground.	Water Sand	80	145'
(4) casing <u>Plastic</u> , <u>140'</u> , (material) (depth), <u>2"</u> if telescope see back. (size)			
(5) screen <u>3'</u> , <u>142'</u> , (length) (depth to top) <u>2"</u> , <u>S.S.</u> , (size) (material)			
(6) pump <u>1 1/2</u> , <u>50</u> , (HP) (yield gpm) <u>electric</u> (type power)			
(7) electric log <u> </u> (yes or no) <u> </u> (organization running log)			
(8) how well bottom plugged <u> </u>			
DRILLERS REMARKS:			
	JUL 19 1972		

If well telescopes please
sketch and show depths.

GROUND LEVEL

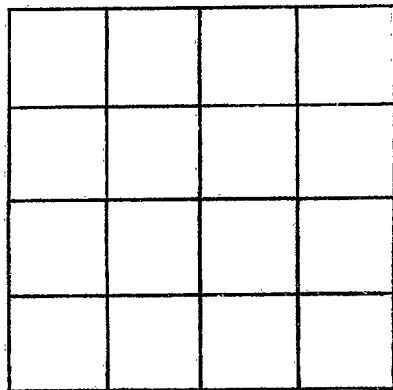

SECTION _____

Please indicate well location X.

ADDITIONAL INFORMATION

If more than one screen,
show locations of each on sketch.