

MARION

D32

3-73

MISSISSIPPI  
 BOARD OF WATER COMMISSIONERS  
 416 North State Street  
 Jackson, Mississippi 39201

**CODED**

WATER WELL DRILLERS LOG

March 73  
date well completed

E. B. Sherrard  
firm name

Marion  
county well located

LANDOWNER:

Kenneth Bennett  
Columbia  
(mailing address)

description of formations encountered

SOFT SANDY  
GRAY CLAY  
SAND + DEBR.

from

to

0 70'  
70 120'

WELL LOCATION:

sec. 2 T. 5 N R. 17 E  
S W  
14 miles NE Columbia  
(distance) (direction) (nearest town)

WELL PURPOSE:

(home) irrigation, municipal, industrial

WELL COMPLETION DATA:

- (1) diameter (inches) 2"
- (2) total depth (feet) 120'
- (3) static water level (feet) 60 <sup>below</sup> above top of ground.
- (4) casing pl. 115'  
(material) (depth)  
2" if telescope see back.  
(size)
- (5) screen 5' pl.  
(length) (depth to top)  
2" (size) (material)
- (6) pump 1 7  
(HP) (yield gpm)  
E  
(type power)
- (7) electric log (yes or no)
- (organization running log)
- (8) how well bottom plugged BWV

**CODED**


Oct 10 1973

DRILLERS REMARKS:

MISS. BD. OF  
WATER COMMISSIONERS

If well telescopes please sketch and show depths.

GROUND LEVEL

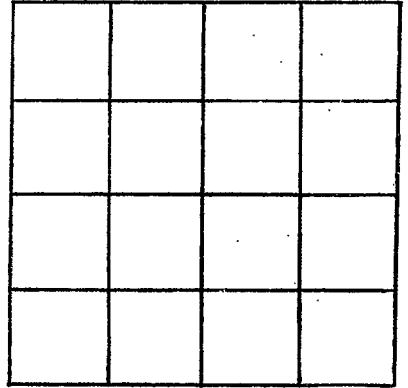

SECTION \_\_\_\_\_

Please indicate well location X.

ADDITIONAL INFORMATION

If more than one screen,  
show locations of each on sketch.