

MARION
D33
2-22-74

MISSISSIPPI
 BOARD OF WATER COMMISSIONERS
 416 North State Street
 Jackson, Mississippi 39201

CODED

WATER WELL DRILLERS LOG
GRINER - GINN

Marion

2-22 19*74*
 date well completed

firm name

county well located

LANDOWNER:
John Blanchard
Rt. 7 *Columbia*
 (mailing address) *Miss.*

description of formations encountered	from	to
<i>Top Soil</i>	<i>0</i>	<i>0</i>
<i>Clay</i>	<i>0</i>	<i>32</i>
<i>Hard Sand</i>	<i>32</i>	<i>71</i>
<i>Gravel</i>	<i>71</i>	<i>92</i>
<i>Sand</i>	<i>92</i>	<i>115</i>

WELL LOCATION:
 sec. *18* T. *5* S. R. *17* E.
1.3 miles *N-E* of *Columbia*
 (distance) (direction) (nearest town)

WELL PURPOSE: *Home*
 (home, irrigation, municipal, industrial)

CODED


- WELL COMPLETION DATA:**
- (1) diameter (inches) *2"*
 - (2) total depth (feet) *115*
 - (3) static water level (feet) *70* below above top of ground.
 - (4) casing *plastic*, *105*,
 (material) (depth)
2" if telescope see back.
 (size)
 - (5) screen *10'*, *105*
 (length) (depth to top)
2", *plastic*
 (size) (material)
 - (6) pump *1* *6*
 (HP) (yield gpm)
elec.
 (type power)
 - (7) electric log *NO*
 (yes or no)
NO
 (organization running log)
 - (8) how well bottom plugged
B.W. Valve

DRILLERS REMARKS:

RECORDED
 INDEXED
 MAY 22 1974
 MISSISSIPPI STATE ARCHIVES

If well telescopes please sketch and show depths.

GROUND LEVEL

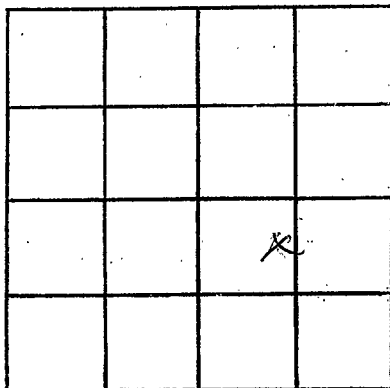

SECTION 18

Please indicate well location X.

ADDITIONAL INFORMATION

If more than one screen, show locations of each on sketch.