

MARION
D 34
4-1-74

MISSISSIPPI
BOARD OF WATER COMMISSIONERS
416 North State Street
Jackson, Mississippi 39201

CODED

WATER WELL DRILLERS LOG

4-1
date well completed

1974 GRINER - GINN
firm name

Marion
county well located

LANDOWNER:
Mr. Elbert Hayden
Rt. 3 Columbia, Miss
(mailing address)

description of formations encountered	from	to
Top Soil	0	1
Clay	1	12
Lat. S. of gravel	12	60
Chalk	60	79
Sand	79	103

WELL LOCATION:
sec. 32 T. 5 S. R. 17 E
1.3 miles NE of Columbia
(distance) (direction) (nearest town)

WELL PURPOSE: Pump
(home, irrigation, municipal, industrial)

CODED

WELL COMPLETION DATA:

(1) diameter (inches) 2"

(2) total depth (feet) 103

(3) static water level (feet) 20 below top of ground.

(4) casing Plastic, 93 (material) (depth)
2" (size) if telescope see back.

(5) screen 10' 93 (length) (depth to top)
2" plastic (size) (material)

(6) pump 1 6 (HP) (yield gpm)
elec (type power)

(7) electric log NO (yes or no)
NO (organization running log)


(8) how well bottom plugged B.W. Valve

DRILLERS REMARKS:

RECEIVED
MAY 22 1974
MISS. Bd. of Water

If well telescopes please sketch and show depths.

GROUND LEVEL

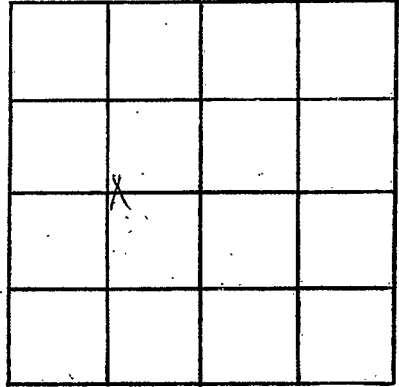

SECTION 32

Please indicate well location X.

ADDITIONAL INFORMATION

If more than one screen, show locations of each on sketch.