

MARION
D 36
12/1/77

MISSISSIPPI
BOARD OF WATER COMMISSIONERS
416 North State Street
Jackson, Mississippi 39201

CODED

WATER WELL DRILLERS LOG

12/1/77 date well completed 19 Griven Drilling Service firm name Marion Co. county well located

LANDOWNER: Carpenter Oil & Gas
#1 Amoco Sabine
(mailing address)

description of formations encountered	from	to
Chalk	0	189
Sand	190	210
Chalk w/ Couple Strata (small)	211	430
Sand	431	504

WELL LOCATION: 18503 E of ww/cor
sec. 8 T 5 S R 17 E
20 miles N of Columbia
(distance) (direction) (nearest town)

CODED

WELL PURPOSE:
(home, irrigation, municipal, industrial)


- WELL COMPLETION DATA:
- (1) diameter (inches) 3'
 - (2) total depth (feet) 523
 - (3) static water level (feet) 70 below top of ground.
 - (4) casing Steel 504' (material) (depth)
 - (size) If telescope see back.
 - (5) screen 42' 483' (length) (depth to top)
 - 3" Perforated Pipe (size) (material)
 - (6) pump 75 (HP) (yield gpm)
 - AC (type power)
 - (7) electric log NO (yes or no)
 - (organization running log)
 - (8) how well bottom plugged orange
 - Per 1

DEC 5 1977
MISS. BD. OF WATER COMM.

DRILLERS REMARKS:
Jimmy Hudson

If well telescopes please sketch and show depths.

GROUND LEVEL

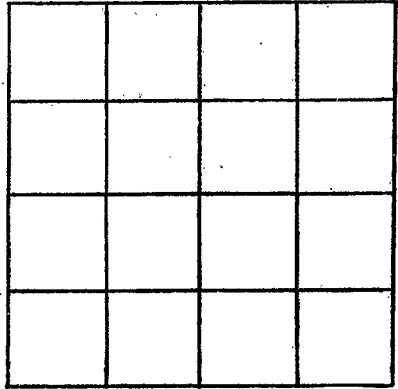

SECTION _____

Please indicate well location X.

ADDITIONAL INFORMATION

If more than one screen, show locations of each on sketch.