

MARION

D37

3/20/78

MISSISSIPPI
BOARD OF WATER COMMISSIONERS
416 North State Street
Jackson, Mississippi 39201

CODED

WATER WELL DRILLERS LOG

3/20/78

date well completed

19

Graver Drilling Service Marion

firm name

county well located

LANDOWNER:

Shell Oil Co.

#1 J. Hutson

(mailing address)

WELL LOCATION:

sec. 28 T. 5 (N)

R. 17 E

1737' N + 2343' E of SW (W) cor

(distance) miles (direction) of (nearest town)

WELL PURPOSE:

(home, irrigation, municipal, industrial)

WELL COMPLETION DATA:

(1) diameter (inches) 3"

(2) total depth (feet) 609

(3) static water level (feet) 170 below top of ground

(4) casing Steel 609' (material) (depth)

3" if telescope see back. (size)

(5) screen 42 567' (length) (depth to top)

3" Perforated Pipe (size) (material)

(6) pump — 70 (HP) (yield gpm)

AC (type power)

(7) electric log NO (yes or no)

(organization running log)

(8) how well bottom plugged Orange Peet

DRILLERS REMARKS:

description of formations encountered

from

to

Sand & Gravel

21 210

Streambed

210 294

mostly Chalk

294 546

well appear small

Stream of Sand

546 609

Sand


RECEIVED

MAR 30 1978

MISS. BD. OF WATER COM

If well telescopes please
sketch and show depths.

GROUND LEVEL

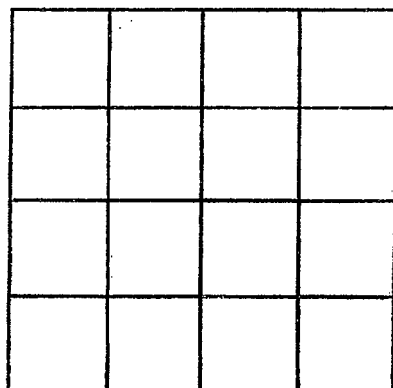

SECTION _____

Please indicate well location X.

ADDITIONAL INFORMATION

If more than one screen,
show locations of each on sketch.