

MISSISSIPPI DEPARTMENT OF NATURAL RESOURCES

Bureau of Land and Water Resources

Southport Mall

P.O. Box 10631

Jackson, Mississippi 39209

WATER WELL DRILLERS LOG

CODED

MARION
D 38
8-5-81

8-5-81 *Gunter Drilling Service, Inc.* Marion *Lamar*
 date well completed firm name county well located

LANDOWNER:	description of formations encountered	from	to
Marion Corporation P.O. Box 3027 Daphne, Ala. 36526 (mailing address)	chalk	0	252
	sand	252	300
	chalk	300	378

WELL LOCATION: 2320' S 41582' W
 #1 sec. 24 5th R. 17th NE 1/4
 Crown Jetties Field
 2 1/2 miles (distance) Siggins (direction) of (nearest town)

WELL PURPOSE: oil field
 (home, irrigation, municipal, industrial)
 supply

- WELL COMPLETION DATA:
- (1) diameter (inches) 4"
 - (2) total depth (feet) 378'
 - (3) static water level (feet) 100' below top of ground.
 - (4) casing steel, 300' (material) (depth)
4" (size) if telescope see back.
 - (5) screen 42' 358' (length) (depth to top)
4" perforated (size) (material)
 - (6) pump 75-80 (HP) (yield gpm)
AC (type power)
 - (7) electric log (yes or no)
(organization running log)
 - (8) how well bottom plugged *orange*
peel

CODED

DEPT. OF NATURAL RESOURCES
 BUREAU OF LAND & WATER RESOURCES

AUG 26 1981


RECEIVED

AUG 1981
RECEIVED
 01 02 03 04 05 06 07 08 09 10 11 12 13 14 15 16 17 18 19 20 21 22 23 24 25 26 27 28 29 30 31

DRILLERS REMARKS:

If well telescopes please sketch and show depths.

GROUND LEVEL

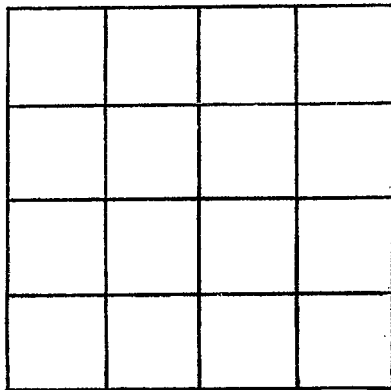

SECTION _____

Please indicate well location X.

ADDITIONAL INFORMATION

If more than one screen,
show locations of each on sketch.