

MISSISSIPPI DEPARTMENT OF NATURAL RESOURCES

Bureau of Land and Water Resources

Southport Mall

P.O. Box 10631

Jackson, Mississippi 39209

WATER WELL DRILLERS LOG

CODED

Griner Drilling Service, Inc.

Marion

MARION
D 4 6
4/18/83

4-18-83 date well completed

Griner Drilling Service, Inc. firm name

Marion county well located

LANDOWNER:

JHJ Drilling
Route 4 Box 618B
Ellisville, MS. 39437
(mailing address)

description of formations encountered

from

to

clay	0	126
streaked	126	312
sand	312	397
clay	397	400

WELL LOCATION: 750'S + 750'W

sec. 25 T 5 N R 12 E NE/CO

No. 1 Broom Unit Higgins Field
2.5 miles (distance) (direction) (nearest town)

WELL PURPOSE: oilfield supply
(home, irrigation, municipal, industrial)

WELL COMPLETION DATA:

- (1) diameter (inches) 3"
- (2) total depth (feet) 400'
- (3) static water level (feet) 80' below above top of ground.
- (4) casing Steel 400'
(material) (depth)
3" if telescope see back.
(size)
- (5) screen 42' 358'
(length) (depth to top)
3" perforated
(size) (material)
- (6) pump 75
(HP) (yield gpm)
AC
(type power)
- (7) electric log
(yes or no)
(organization running log)

CODED

DEPT. OF NATURAL RESOURCES
BUREAU OF LAND & WATER RESOURCES


MAY 16 1983

RECEIVED

(8) how well bottom plugged OBUSE
steel
DRILLERS REMARKS:

If well telescopes please sketch and show depths.

GROUND LEVEL

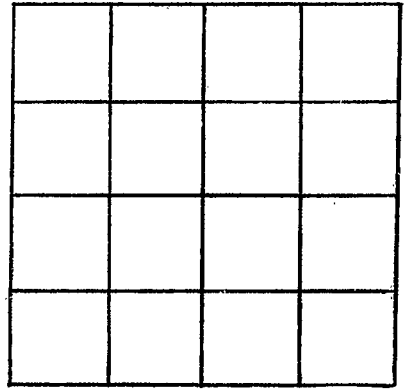

SECTION _____

Please indicate well location X.

ADDITIONAL INFORMATION

If more than one screen, show locations of each on sketch.