

# State Well Report

## Part 1

Mississippi Department of Environmental Quality  
Office of Land and Water Resources  
P.O. Box 10631  
Jackson, MS 39289-0631  
(601)961-5210  
(601)354-6938 (fax)

### For Office Use Only:

Aquifer: \_\_\_\_\_  
Well #: D-57  
L. S. Elevation: D \_\_\_\_\_  
E-log #: \_\_\_\_\_

County: MARION 09  
Permit #: \_\_\_\_\_  
Driller: JACKIE STUCKEY  
Date drilling completed: 8-7-04

State Law requires that this report be prepared by the driller in detail and filed with the Department within 30 days of completion of drilling of the well.

Well Owner Information	Well Location
Owner Name: <u>EDWARD STRINGER</u>	Latitude: <u>31° 21' 34"</u> Longitude: <u>81° 44' 48"</u>
Mailing Address: <u>450 GOOD HOPE ROAD</u>	Method of Lat/Long (circle one): <u>Conventional Survey</u>
<u>COLUMBIA MS 39429</u> City State Zip Code	USGS quad, Hand-held GPS, Survey-grade GPS <u>NW 1/4 NE 1/4 Sec 31 Twn 5N Rng 17W</u>
Telephone No. <u>(601) 736 0162</u>	Distance Direction Nearest Town <u>8 Miles NE of COLUMBIA</u>

### Well Data

Purpose of Well (circle one) Home Industrial Public Supply Irrigation Fish Culture Other: \_\_\_\_\_  
Date well drilling started: 8-7-04 Date well drilling completed: 8-7-04  
If flowing, method of flow regulation: Valve \_\_\_\_\_ Other (describe) \_\_\_\_\_  
Static Water Level: 95' feet above or below (circle one) land surface Date measured: 8-7-04  
Method of Measurement (circle one) steel tape electric tape air line other: \_\_\_\_\_  
Hole depth: 167' Well depth: 165' Well grouted to a depth of 10 feet  
Type of grout (circle one): Cement Bentonite Mix  
Casing length: 20' feet Casing diameter: 4" inches Type of casing: P.V.C.  
Screen length: 10' feet Screen diameter: 4" inches Type of screen: P.V.C. SLOTTED  
Screen slot size: .008 inches Setting depth: From 155' feet to 165' feet  
Type of completion (circle all applicable): Gravel packed Underreamed Telescoped Open hole Natural Development  
Other (describe): \_\_\_\_\_  
Top of lap pipe or reduction in casing: \_\_\_\_\_ feet. If telescoped or more than one screen, describe on back of page  
Logs run (circle all applicable): No log run Electric Gamma Ray Density Sonic Neutron Other: \_\_\_\_\_  
Name of organization running log(s): \_\_\_\_\_

I certify that the well was drilled, constructed, and completed in accordance with all applicable requirements of the Mississippi Department of Environmental Quality and/or the Mississippi Department of Health regulations and state laws.

STUCKEY'S WELL SERVICE INC  
Print Name of Water Well Contractor and License No. 0-686

Jackie Stuckey  
Signature of Water Well Contractor

RECEIVED  
AUG 30 2004  
BY: OLWR

If well telescopes please sketch below and show depths.

Ground Level


D-57



Description of Formations Encountered	From	To
CLAY	1'	20'
CLAY + SAND	21'	88'
SAND + PEH GRAVEL	89'	165'

If more than one screen, show location of each on sketch

Sketch the property layout and include the following: 1) the well location; 2) any permanent structures on the property that may aid in locating the well; 3) any roads, power lines, or other items that may aid in locating the property and the well; 4) indicate direction.

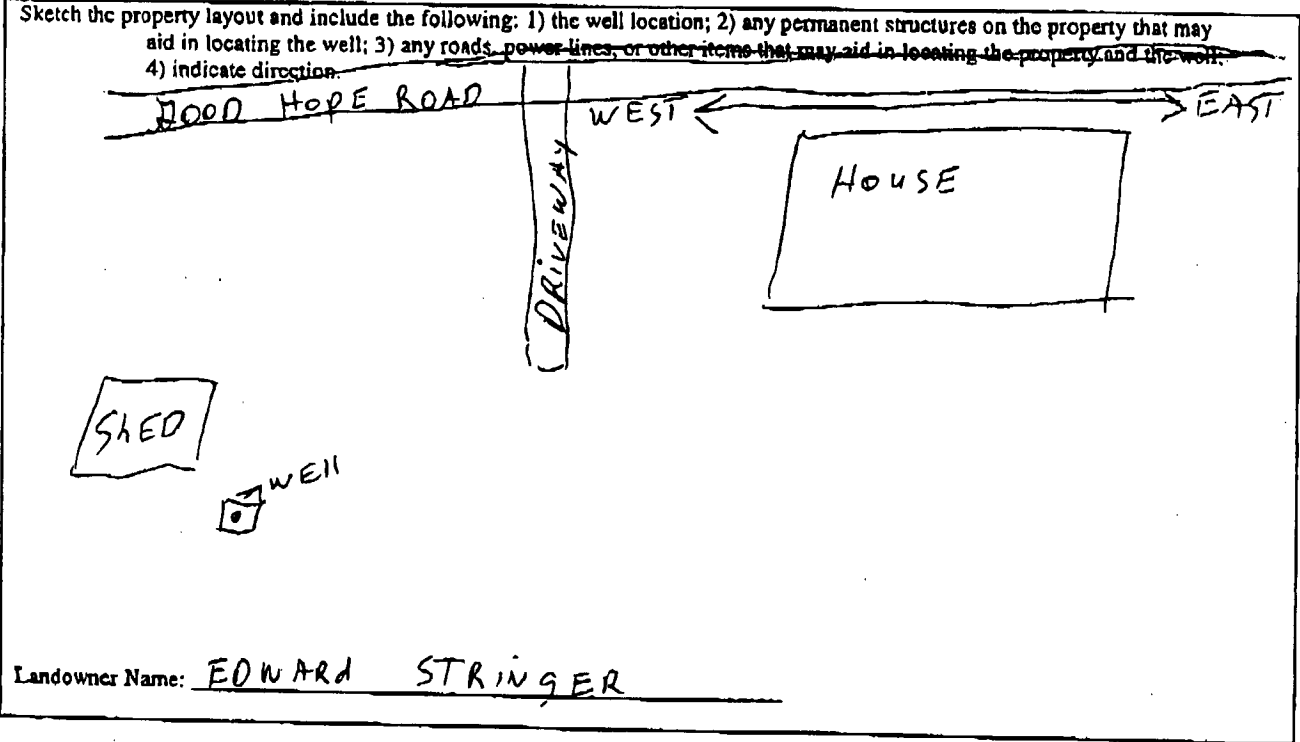

Landowner Name: EDWARD STRINGER

Jackie Stringer  
Signature of Water Well Contractor

# STATE WELL REPORT

## Part 2

**Pump Installer's Completion Report**  
 Mississippi Department of Environmental Quality  
 Office of Land and Water Resources  
 P.O. Box 10631  
 Jackson, MS 39289-0631  
 (601)961-5210  
 (601)354-6938 (fax)

For Office Use Only:

Aquifer: \_\_\_\_\_

Well #: D-57

Elevation: \_\_\_\_\_

County: MARION

Permit #: \_\_\_\_\_

Driller: JACKIE STUCKEY

Date completed: 8-7-04

**This report should be prepared by the pump installer in detail and filed with the Department within 30 days of the installation of pump.**

Well Owner Information	Well Location
Owner Name: <u>EDWARD STRINGER</u>	Latitude: _____ Longitude: _____
Mailing Address: <u>450 Dood HOPE ROAD</u>	Method of Lat/Long (circle one): <u>Conventional Survey</u>
<u>COLUMBIA, MS 39429</u> City State Zip Code	USGS quad, Hand-held GPS, Survey-grade GPS
Telephone No. <u>(601) 736-0162</u>	_____ 1/4 _____ 1/4 Sec <u>31</u> Twn <u>5N</u> Rng <u>17W</u>
	Distance Direction Nearest Town
	<u>8</u> Miles <u>N.E.</u> of <u>COLUMBIA</u>

Pump Type Circle one	Power Type Circle one
Air Lift Jet <u>Submersible</u>	Diesel Engine Gasoline Engine Natural Gas
Bucket Piston Turbine	<u>Electric Motor</u> Hand Tractor PTO
Centrifugal Rotary Flowing Well	Windmill Other (specify): _____
Other (specify): _____	Horse Power Rating of Motor: <u>1</u>
Date Pump Installed: <u>8-7-04</u>	Setting Depth: <u>140'</u> feet
Rated Pump Capacity: <u>19</u> Gallons Per Minute	Number of Stages: _____

Pump Test Data	Method of Measuring Water Level Circle one
Date Well Tested: <u>8-7-04</u>	Air Line Electric Measuring Line <u>Steel Tape</u>
Static Water Level (A): <u>95'</u> Feet Below Land Surface	Other (specify): _____
Pumping Water Level (B): _____ Feet Below Land Surface	For flowing well, measured shut in head: _____ feet
Drawdown [(B) - (A)]: _____ Feet Below Land Surface	Well yielded _____ GPM with a drawdown of _____ feet after _____ hours of pumping
Test Pumping Rate: _____ Gallons Per Minute	
Duration of Pump Test (minimum 4 hours): _____ hours	

I HEREBY CERTIFY that the above statements are true to the best of my knowledge.

JACKIE STUCKEY - 0-686  
 Print Name of Pump Installer and License No. (if applicable)

Jackie Stuckey  
 Signature of Pump Installer

RECEIVED

AUG 30 2004

BY: OLWR