

County: Marion
 Permit #: 0-586
 Driller: JAMES WELLS
 Date drilling completed: 8-23-12

State Well Report
Part 1 - Driller's Log
 Mississippi Department of Environmental Quality
 Office of Land and Water Resources
 P.O. Box 2309
 Jackson, MS 39225
 (601)961- 5210
 (601)961- 5228 (fax)

For Office Use Only:
 Aquifer: _____
 Well #: D 84
 L. S. Elevation: _____
 E-log #: _____

State Law requires that this report be prepared by the license holder responsible for the work and filed with the Department at the above address within 30 days of completion of drilling of the well or borehole.

Information on Well Owner (Landowner if borehole is not for a water well)	Well or Borehole Location
Owner Name: <u>Steven Stringer</u>	Latitude: <u>31° 21' 16"</u> Longitude: <u>89° 44' 29"</u>
Mailing Address: <u>1026 Hester Rd</u> <u>Columbia Ms</u> <u>39429</u>	Method of Lat/Long (circle one): Conventional Survey, USGS quad, Hand-held GPS, Survey-grade GPS
City: _____ State: _____ Zip Code: _____	NW ¼ SE ¼ Sec <u>31</u> ✓ Twn <u>4N</u> Rng <u>17W</u> ✓
Telephone No. <u>(601) 736 9491</u>	Distance _____ Miles Direction <u>North</u> of Nearest Town <u>Columbia</u>

Well / Borehole Data

Date drilling started: 8-23-12 Date drilling completed: 8-23-12 Hole depth: 120 Hole diameter: 7

Location of the source of any surface water used for drilling: creek

Method of dosing and volume of Chlorine used in drilling and development: Shock 24

Logs run (circle all applicable): No log run Electric Gamma Ray Density Sonic Neutron Other: _____

Name of organization running log(s): _____

Purpose of borehole (check one): Water Well Geotechnical/Geological Investigation _____ Ground Source Heat Pump _____

Seismic Survey _____ Other (describe) _____

If drilling is not related to water well construction, skip the remainder of this block

Purpose of Well (check one): Home Industrial _____ Public Supply _____ Irrigation _____ Fish Culture _____ Other: _____

If a flowing well, method of flow regulation: Valve _____ Other (describe) _____

Static Water Level: _____ 60 feet above or below (circle one) land surface Date measured: 8-23-12

Method of Measurement (circle one) steel tape electric tape air line other: _____

Well depth: 110 Well grouted to a depth of 10 feet Type of grout (circle one): Neat Cement Bentonite Mix

Casing length: 90 feet Casing diameter: 4 inches Type of casing: PVC

Screen length: 20 feet Screen diameter: 4 inches Type of screen: PVC

Screen slot size: .008 inches Setting depth: From 90 feet to 110 feet

Type of completion (circle all applicable): Gravel packed Underreamed Telescoped Open hole Natural Development

Other (describe): _____

Top of lap pipe or reduction in casing: _____ feet. *If telescoped or more than one screen, describe on next page*

Form: OLWR-SWR-1A (04/08)

RECEIVED
 OCT 04 2012
 BY: OLWR

If well telescopes please sketch below and show depths.

D84

Ground Level


Description of Formations Encountered

From To

Description of Formations Encountered	From	To
Top Soil	0	2
ch. soil	2	36
Sand	36	110

If more than one screen, show location of each on sketch

Sketch the property layout and include the following: 1) the well location; 2) any permanent structures on the property that may aid in locating the well; 3) any roads, power lines, or other items that may aid in locating the property and the well; 4) indicate direction.

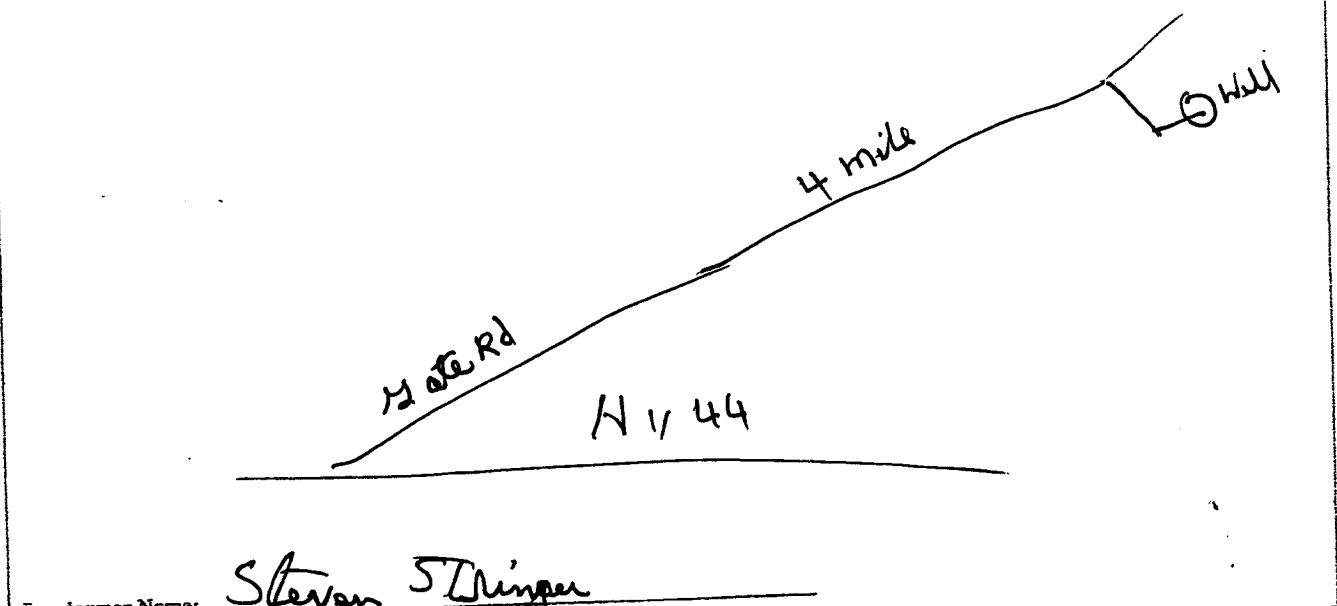

Landowner Name: Stevan Stringer

James Wells
Signature of Water Well Contractor

RECEIVED
OCT 04 2012
BY: OLWR

STATE WELL REPORT

Part 2

Pump Installer's Completion Report
 Mississippi Department of Environmental Quality
 Office of Land and Water Resources
 P.O. Box 10631
 Jackson, MS 39289-0631
 (601)961-5210
 (601)354-6938 (fax)

For Office Use Only:

County: Marion
 Permit #: _____
 Driller: JAMES WELLS
 Date completed: 8-23-12

Aquifer: _____
 Well #: D84
 Elevation: _____

This report should be prepared by the pump installer in detail and filed with the Department within 30 days of the installation of pump.

Well Owner Information	Well Location
Owner Name: <u>Steven Stringer</u>	Latitude: <u>33-21-166</u> Longitude: <u>90 89.44.790</u>
Mailing Address: <u>1026 Gate Rd</u>	Method of Lat/Long (circle one): <input type="radio"/> Conventional Survey,
<u>Columbia MS</u>	<input type="radio"/> USGS quad, <input type="radio"/> Hand-held GPS, <input type="radio"/> Survey-grade GPS
<u>39429</u>	<u>NW 1/4 SE 1/4 Sec 31 Twn 4N Rng 17W</u>
City State Zip Code	Distance Direction Nearest Town
Telephone No. (601) <u>7369491</u>	<u>7</u> Miles <u>North</u> of <u>Columbia ms</u>

Pump Type Circle one	Power Type Circle one
Air Lift: Jet <input type="radio"/> <u>Submersible</u>	Diesel Engine <input type="radio"/> Gasoline Engine <input type="radio"/> Natural Gas <input type="radio"/>
Bucket: Piston <input type="radio"/> Turbine <input type="radio"/>	Electric Motor <input type="radio"/> Hand <input type="radio"/> Tractor PTO <input type="radio"/>
Centrifugal: Rotary <input type="radio"/> Flowing Well <input type="radio"/>	Windmill <input type="radio"/> Other (specify): _____
Other (specify): _____	Horse Power Rating of Motor: <u>1 1/2</u>
Date Pump Installed: <u>8-23-12</u>	Setting Depth: <u>80</u> feet
Rated Pump Capacity: <u>25</u> Gallons Per Minute	Number of Stages: <u>11</u>

Pump Test Data	Method of Measuring Water Level Circle one
Date Well Tested: <u>8-23-12</u>	Air Line <input type="radio"/> Electric Measuring Line <input type="radio"/> Steel Tape <input type="radio"/>
Static Water Level (A): <u>60</u> Feet Below Land Surface	Other (specify): _____
Pumping Water Level (B): <u>80</u> Feet Below Land Surface	For flowing well, measured shut in head: _____ feet
Drawdown [(B) - (A)]: <u>20</u> Feet Below Land Surface	Well yielded <u>25</u> GPM with a drawdown of
Test Pumping Rate: <u>25</u> Gallons Per Minute	<u>60</u> feet after <u>4</u> hours of pumping
Duration of Pump Test (minimum 4 hours): <u>4</u> hours	

I HEREBY CERTIFY that the above statements are true to the best of my knowledge.

JAMES WELLS 0-586 James Wells
 Print Name of Pump Installer and License No. (if applicable) Signature of Pump Installer

RECEIVED
 OCT 04 2012
 BY: OLWR