

Marion
D 2001
11/75

MISSISSIPPI
BOARD OF WATER COMMISSIONERS
416 North State Street
Jackson, Mississippi 39201

WATER WELL DRILLERS LOG

Nov. 1975 E.B. Sheppard Marion
date well completed firm name county well located

LANDOWNER:
Calvin Bass
Columbia, Ms.
(mailing address)

description of formations encountered	from	to
GRAVEL	0	80'
GRAVELLY COARSE SAND & GRA.	80	105'

WELL LOCATION:
sec. 32 T 5 N R. 17 E 13V
S W
8 miles NE of Columbia
(distance) (direction) (nearest town)

WELL PURPOSE:
(home) Irrigation, municipal, industrial

- WELL COMPLETION DATA:
- (1) diameter (inches) 2"
 - (2) total depth (feet) 105'
 - (3) static water level (feet) 60' ^{below} above top of ground.
 - (4) casing pl. 100' (material) (depth)
2" (size) if telescope see back.
 - (5) screen 5' (length) (depth to top)
2" (size) pl. (material)
 - (6) pump 1 (HP) 7 (yield gpm)
E (type power)
 - (7) electric log (yes or no) no
(organization running log)
 - (8) how well bottom plugged BWV


DRILLERS REMARKS:

RECEIVED
DEC 5 1975

MISS. BD. OF WATER COMMISSIONERS

If well telescopes please
sketch and show depths.

GROUND LEVEL

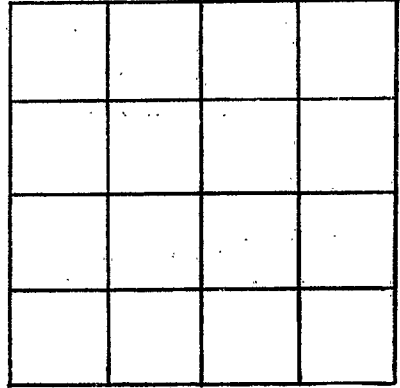

SECTION _____

Please indicate well location X.

ADDITIONAL INFORMATION

If more than one screen,
show locations of each on sketch.