

Marion
D 200
2/1976

MISSISSIPPI
BOARD OF WATER COMMISSIONERS
416 North State Street
Jackson, Mississippi 39201

WATER WELL DRILLERS LOG

Feb. 1976 E.B. Sherrard Marion
date well completed firm name county well located

LANDOWNER:
Kenneth Robbins
Bassfield, Miss.
(mailing address)

description of formations encountered	from	to
GRAY SANDY		
CLAY STREAKS	0	70'
DEEP GR. & SAND	70	96'

WELL LOCATION:
sec. 6 T 50 N R 17 E
S W
5 miles S of Bassfield
(distance) (direction) (nearest town)

WELL PURPOSE:
(home, irrigation, municipal, industrial)

- WELL COMPLETION DATA:
- (1) diameter (inches) 2"
 - (2) total depth (feet) 96'
 - (3) static water level (feet) 45' below top of ground.
 - (4) casing pl. 91' (material) (depth)
2" (size) if telescope see back.
 - (5) screen 5' (length) (depth to top)
2" (size) pl. (material)
 - (6) pump 3/4 (HP) 7 (yield gpm)
elec. (type power)
 - (7) electric log (yes or no)
- (organization running log)

(8) how well bottom plugged BWV


DRILLERS REMARKS:

RECEIVED

OCT 18 1976

If well telescopes please sketch and show depths.

GROUND LEVEL

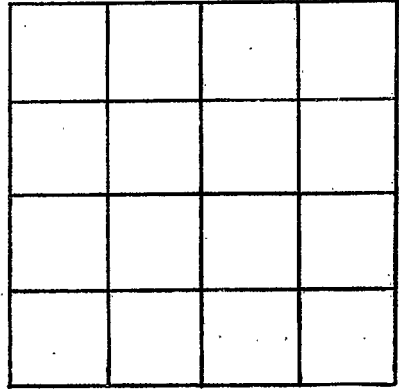

SECTION _____

Please indicate well location X.

ADDITIONAL INFORMATION

A series of horizontal lines providing space for additional information.

If more than one screen, show locations of each on sketch.