

Marion
D 2003
5/27/77

MISSISSIPPI
BOARD OF WATER COMMISSIONERS
416 North State Street
Jackson, Mississippi 39201

13V

WATER WELL DRILLERS LOG

5/27 1977 Hollinger Plumbing Marion
date well completed firm name county well located

LANDOWNER: Dennis Little
Rt 3 Box 38 A
Columbia, Miss.
(mailing address)

description of formations encountered	from	to
CHALK	0	75
SAND	75	115

WELL LOCATION:
sec. 26 T 5 N R 17 E
2 1/2 miles N.E. of Improve
(distance) (direction) (nearest town)

WELL PURPOSE: Home
(home, irrigation, municipal, industrial)

WELL COMPLETION DATA:

(1) diameter (inches) 4"

(2) total depth (feet) 115

(3) static water level (feet) 70 below top of ground.

(4) casing PVC, 105' (depth)
(size) If telescope see back.

(5) screen 10' length, 105' depth to top
4" size, PVC material

(6) pump 3/4 HP, 12 yield gpm
elect type power

(7) electric log (yes or no)

(organization running log)

(8) how well bottom plugged. SAND SHARK


DRILLERS REMARKS: very good well

RECEIVED
JUN 25 1977

MISS. Bd. OF WATER COMMISSIONERS

If well telescopes please sketch and show depths.

GROUND LEVEL

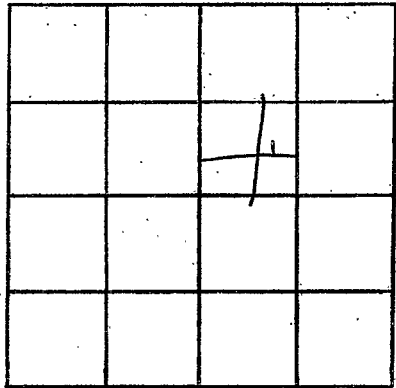

SECTION 26

Please indicate well location X.

ADDITIONAL INFORMATION

If more than one screen,
show locations of each on sketch.