

MARION
 D 2004
 12/6/77

MISSISSIPPI
 BOARD OF WATER COMMISSIONERS
 416 North State Street
 Jackson, Mississippi 39201

WATER WELL DRILLERS LOG

12/6 date well completed 977 Hollingsa Well Serv. firm name Marion county well located

LANDOWNER: Billy Don Rayburn
 P.O. Box 230
 Columbia Ms
 (mailing address)

description of formations encountered	from	to
	CHALK GRAVEL	0
SAND GRAVEL	20	100

WELL LOCATION:
 sec ³² T ³⁰ N R ¹⁷ E
 4 5 S (distance) miles ^{NW} of IMPROVE (direction) (nearest town)

WELL PURPOSE: Home
 (home, irrigation, municipal, industrial)

WELL COMPLETION DATA:

(1) diameter (inches) 2"

(2) total depth (feet) 100

(3) static water level (feet) 22 ^{below} top of ground. above

(4) casing PVC 95 (material) (depth)

(size) if telescope see back.

(5) screen 5 95 (length) (depth to top)

2" PVC (size) (material)

(6) pump 1 12 (HP) (yield gpm)

elect. (type power)

(7) electric log (yes or no)

(organization running log)


(8) how well bottom plugged Sand SHARK

DRILLERS REMARKS: good well

RECEIVED
 FEB 10 1978

If well telescopes please sketch and show depths.

GROUND LEVEL

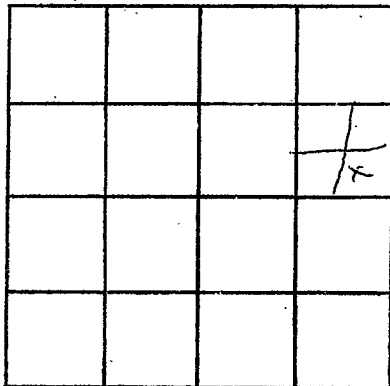

SECTION 32

Please indicate well location X.

ADDITIONAL INFORMATION

If more than one screen, show locations of each on sketch.