

MARION
 D 2005
 2-24-78

MISSISSIPPI
 BOARD OF WATER COMMISSIONERS
 416 North State Street
 Jackson, Mississippi 39201

WATER WELL DRILLERS LOG

2/24 1978 date well completed
 Tom Griffith Well firm name
 Marion county well located
 Service

LANDOWNER:
 Mr. Shelby M. Stringer
 Rt. 1 - Columbia
 (mailing address)

description of formations encountered	from	to
top soil	0	1
clay	1	60
clay	60	90
sand	90	100

WELL LOCATION:
 sec. 33 T. 50_S R. 17 E
 10 miles NE of Columbia
 (distance) (direction) (nearest town)

WELL PURPOSE:
 home
 (home, irrigation, municipal, industrial)

WELL COMPLETION DATA:

(1) diameter (inches) 2"

(2) total depth (feet) 100ft

(3) static water level (feet) _____ below above top of ground.

(4) casing plastic 80ft
 (material) (depth)
 2" (size) if telescope see back.

(5) screen 20ft, 80ft
 (length) (depth to top)
 2" (size) plastic (material)

(6) pump 1/2 HP (HP) _____ (yield gpm)
 Electric (type power)

(7) electric log no (yes or no)
 (organization running log) N/A

(8) how well bottom plugged
 B. W. Value


RECEIVED
 APR 27 1978

DRILLERS REMARKS:

MISS. BD. OF WATER COMMISSIONERS

If well telescopes please sketch and show depths.

GROUND LEVEL

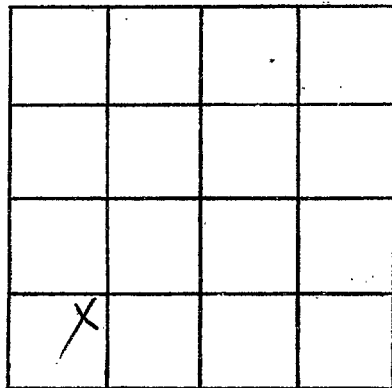

SECTION 33

Please indicate well location X.

ADDITIONAL INFORMATION

If more than one screen,
show locations of each on sketch.