

MISSISSIPPI DEPARTMENT OF NATURAL RESOURCES

Bureau of Land and Water Resources

Southport Mall

P.O. Box 10631

Jackson, Mississippi 39209

WATER WELL DRILLERS LOG

Maçon
D 2006

12-23-82 19 Walker Welding Maçon
 date well completed firm name county well located

LANDOWNER: Funell Williams
655 Hailey Ave
Shidell La
 (mailing address)

Description of formations encountered	from	to
<u>Red shale</u>	<u>0</u>	<u>20</u>
<u>Ground</u>	<u>20</u>	<u>72</u>
<u>Blue shale</u>	<u>72</u>	<u>126</u>
<u>Sand</u>	<u>126</u>	<u>182</u>

WELL LOCATION:
 sec 33 T 5 N R 17 E
0.8 miles NE of Columbia
 (distance) (direction) (nearest town)

WELL PURPOSE: Home
 (home, irrigation, municipal, industrial)

WELL COMPLETION DATA:
 (1) diameter (inches) 4"
 (2) total depth (feet) 182'
 (3) static water level (feet) 126 below above top of ground.
 (4) casing PVC 172'
 (material) (depth)
 (size) if telescope see back.
 (5) screen 10' 172'
 (length) (depth to top)
12 PVC
 (size) (material)
 (6) pump 1 14
 (HP) (yield gpm)
Elec
 (type power)
 (7) electric log _____
 (yes or no)

 (organization running log)
 (8) how well bottom plugged: Sand
Sand

DRILLERS REMARKS: _____


DEPT. OF NATURAL RESOURCES
 BUREAU OF LAND & WATER RESOURCES

JAN 11 1983

RECEIVED

If well telescopes please sketch and show depths.

GROUND LEVEL

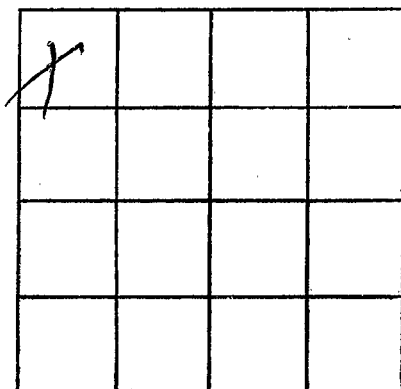

SECTION _____

Please indicate well location X.

ADDITIONAL INFORMATION

If more than one screen,
show locations of each on sketch.