

MISSISSIPPI DEPARTMENT OF NATURAL RESOURCES

Bureau of Land and Water Resources

Southport Mall

P.O. Box 10631

Jackson, Mississippi 39209

WATER WELL DRILLERS LOG

Marion
D
2007

11-30-82 date well completed

Griner Drilling Service, Inc. firm name

Marion county well located

LANDOWNER:

Cockrell Oil Corporation
 Suite 999 Main Bldg.
 Houston, Texas 77062
 (mailing address)

description of formations encountered

from

to

sand, gravel	0	168
streaked clay	168	462
sand	462	504

WELL LOCATION: 2450'N + 1730'E

sec. 7 T. 50 N R. 17 E S. 10

no. 1 T. Melling
 miles E of
 (distance) (direction) (nearest town)

WELL PURPOSE: oilfield supply
 (home, irrigation, municipal, industrial)

WELL COMPLETION DATA:

- (1) diameter (inches) 4"
- (2) total depth (feet) 504'
- (3) static water level (feet) 90' below top of ground.
- (4) casing Steel 504' (material) (depth)
 4" (size) if telescope see back.
- (5) screen 42' 462' (length) (depth to top)
 4" perforated (size) (material)
- (6) pump (HP) 75 (yield gpm)
 AC (type power)
- (7) electric log (yes or no)

(organization running log)

(8) how well bottom plugged orange

DRILLERS REMARKS: peel


DEPT. OF NATURAL RESOURCES
 BUREAU OF LAND & WATER RESOURCES

DEC 20 1982

RECEIVED

If well telescopes please sketch and show depths.

GROUND LEVEL

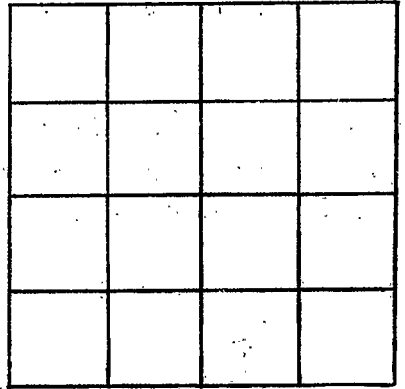

SECTION _____

Please indicate well location X.

ADDITIONAL INFORMATION

If more than one screen,
show locations of each on sketch.