

MISSISSIPPI DEPARTMENT OF NATURAL RESOURCES

Bureau of Land and Water Resources

Southport Mall

P.O. Box 10631

Jackson, Mississippi 39209

WATER WELL DRILLERS LOG

PLUMBING & WELL SERVICE, INC.

220 MAYSON AVE.
COLUMBIA, MS 39429

Marion
D2008

2/16 1983
date well completed

Marion
county well located

LANDOWNER: Deway Green

description of formations encountered

from to

782

Topsoil

0' 1'

Columbia, MS
(mailing address)

Chalk

1' 30'

WELL LOCATION:

sec. 23 T. 5 N. R. 17 E. W
S (distance) (direction) (nearest town)

Sand

30' 65'

WELL PURPOSE: home
(home, irrigation, municipal, industrial)

WELL COMPLETION DATA:

- (1) diameter (inches) 4"
- (2) total depth (feet) 65'
- (3) static water level (feet) 20 below above top of ground.
- (4) casing PVC, 55',
(material) (depth)
- N/A if telescope see back.
(size)
- (5) screen 10', 55'
(length) (depth to top)
- 4", PVC #10
(size) (material)
- (6) pump 1/2, 10
(HP) (yield gpm)
- Elec
(type power)
- (7) electric log none
(yes or no)
- N/A
(organization running log)
- (8) how well bottom plugged BWU

DEPT. OF NATURAL RESOURCES
BUREAU OF LAND & WATER RESOURCES


MAR - 9 1983

RECEIVED

DRILLERS REMARKS:

If well telescopes please sketch and show depths.

GROUND LEVEL

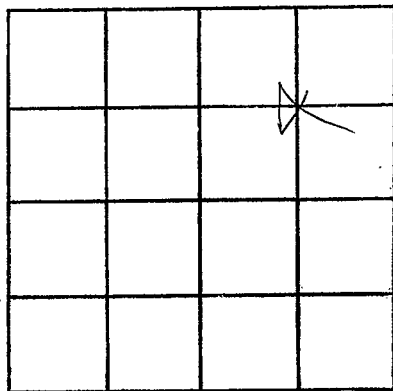

SECTION 23

Please indicate well location X.

ADDITIONAL INFORMATION

If more than one screen,
show locations of each on sketch.