

MISSISSIPPI DEPARTMENT OF NATURAL RESOURCES

Bureau of Land and Water Resources

Southport Mall

P.O. Box 10631

Jackson, Mississippi 39209

WATER WELL DRILLERS LOG

TOM GRIFFITH

PLUMBING & WELL SERVICE, INC.

Marion

firm name: MAYSUN AVE.
COLUMBIA, MISS 39223

county well located

Marion
D
2009

1/24 19 83
date well completed

LANDOWNER: Major Patterson

description of formations encountered

from to

276

Topsoil

0' 1'

Columbia, MS
(mailing address)

Chalk

1' 20'

sand

20' 100'

WELL LOCATION:

sec. 22 T. 5 N. R. 17 E.
S W
10 miles W of Columbia
(distance) (direction) (nearest town)

WELL PURPOSE: home
(home, irrigation, municipal, industrial)

WELL COMPLETION DATA:

- (1) diameter (inches) 2"
- (2) total depth (feet) 100'
- (3) static water level (feet) 50 below above top of ground.
- (4) casing PVC, 90',
(material) (depth)
N/A if telescope see back.
(size)
- (5) screen 10', 90'
(length) (depth to top)
4", PVC slot
(size) (material)
- (6) pump Centurion's Pump
(HP) (yield gpm)
10A
(type power)
- (7) electric log none
(yes or no)
N/A
(organization running log)
- (8) how well bottom plugged BWU

DRILLERS REMARKS:


DEPT. OF NATURAL RESOURCES
BUREAU OF LAND & WATER RESOURCES

MAR 9 1983

RECEIVED

If well telescopes please sketch and show depths.

GROUND LEVEL

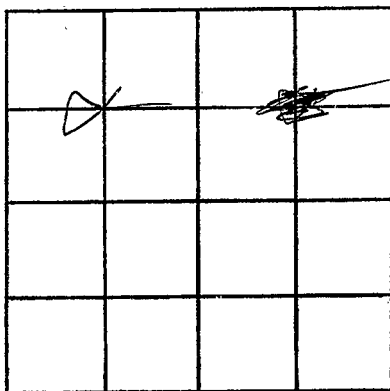

SECTION _____

Please indicate well location X.

ADDITIONAL INFORMATION

If more than one screen,
show locations of each on sketch.