

**MISSISSIPPI DEPARTMENT OF NATURAL RESOURCES**  
**Bureau of Land and Water Resources**  
 Southport Mall  
 P.O. Box 10631  
 Jackson, Mississippi 39209  
**WATER WELL DRILLERS LOG**

Marion  
D 2010

5-17 1983 Hollinger Well Service Marion  
 date well completed firm name county well located

LANDOWNER: Grace Pittman  
RT 4  
Columbia ms  
 (mailing address)

description of formations encountered	from to	
<u>Sand &amp; clay</u>	<u>0</u>	<u>10</u>
<u>Chalk clay</u>	<u>10</u>	<u>30</u>
<u>Sand, fine gravel</u>	<u>30</u>	<u>45</u>

WELL LOCATION:  
 sec. 21 T-5 N R-19 E  
 (distance) miles at of Hartman  
 (direction) (nearest town)

WELL PURPOSE:  
 (home, irrigation, municipal, industrial)

- WELL COMPLETION DATA:
- diameter (inches) 2"
  - total depth (feet) 45
  - static water level (feet) 15 below above top of ground.
  - casing PVC, 35  
 (material) (depth)  
 If telescope see back.  
 (size)
  - screen 5, 40  
 (length) (depth to top)  
2", PVC  
 (size) (material)
  - pump 1HP, 12  
 (HP) (yield gpm)  
elect  
 (type power)
  - electric log (yes or no) \_\_\_\_\_  
 (organization running log) \_\_\_\_\_
  - how well bottom plugged sand  
SHARK

DRILLERS REMARKS: Very good well


DEPT. OF NATURAL RESOURCES  
 BUREAU OF LAND & WATER RESOURCES

SEP 27 1983

**RECEIVED**

If well telescopes please sketch and show depths.

GROUND LEVEL

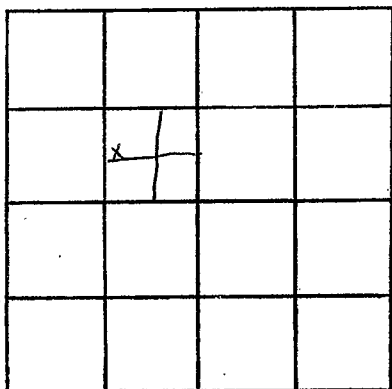

SECTION 21

Please indicate well location X.

ADDITIONAL INFORMATION

If more than one screen,  
show locations of each on sketch.