

MISSISSIPPI DEPARTMENT OF NATURAL RESOURCES
Bureau of Land and Water Resources

P.O. Box 10631
Jackson, Mississippi 39209
WATER WELL DRILLERS LOG

MARION
COUNTY WELL LOCATED
WALTON
WELL NUMBER CODED
D 2012
DATE WELL COMPLETED
27-89

PERMIT NUMBER
0-428
NAME OF DRILLING FIRM
WALKER WELL DRILLING SERVICE

NAME & MAILING ADDRESS OF LANDOWNER
Jones Lumber Co.
improve Ms. Rt 1 Box 87
Sandy Hook Ms. 39478
WELL LOCATION: SEC TOWNSHIP RANGE
5 N 17 E
DISTANCE DIRECTION NEAREST TOWN
2 Miles N of improve
OTHER LANDMARK
Jones Lumber Co
WELL PURPOSE: Home, Irrigation, Municipal, Industrial, Fish Pond, etc.

PUMP DATA

PUMP TYPE (Circle One):
 Submersible Turbine Jet Flowing Well,
Other (Describe) _____

POWER TYPE (Circle One):
 Electric Tractor, Diesel, Gasoline, Butane,
Other (Describe) _____

Pump Capacity (GPM) No. of Stages Setting Depth
50 11 130 FT.

PUMP TEST
Well yielded _____ GPM with
a drawdown of _____ ft.
after _____ hours of pumping

WELL DATA

Well Depth <i>140</i>	Casing Diameter (In.) <i>4</i>	Casing Length (Ft.) <i>180</i>
Type of Casing <i>PVC</i>	Hole Depth <i>141'</i>	Depth to Static Water Level <i>40'</i>

TYPE OF COMPLETION: (Circle One or More):
 Gravel Packed, Underreamed, Telescoped,
 Natural Development, Open Hole, Other
(Describe) *AIR*

Top of Lap Pipe or Reduction in Casing
FEET IF TELESCOPED OR MORE THAN ONE SCREEN: USE BACK PAGE

LOG DATA

TYPE OF LOG RUN (Circle One): No Log Run, Electric, Gamma Ray, Density, Sonic, Neutron, Other (Describe) _____

Name of Organization Running Log

SCREEN DATA

Diameter - Inches <i>4</i>	Length - Feet <i>20'</i>	Slot Size - Inches <i>#10</i>
Screen Type <i>EURAP</i>	Depth to Bottom - Feet <i>138</i>	

GEOLOGIC DATA (Office Use Only)

Surface Elev.	Geologic Unit	Unit Thickness	Depth to Top
Subs. SWL	Date	Analysis	Aquifer Test


Driller's Remarks

DESCRIPTION OF FORMATIONS ENCOUNTERED	FROM	TO	FORMATIONS (Continued)	
			FROM	TO
<i>RED CLAY</i>	<i>0</i>	<i>15</i>	RECEIVED <i>FEB 8 1989</i> Department of Natural Resources Bureau of Land & Water Resources	
<i>ROCKS PART</i>	<i>15</i>	<i>25</i>		
<i>SAND</i>	<i>25</i>	<i>90</i>		
<i>PEGRAVLE</i>	<i>90</i>	<i>140</i>		

IF MORE SPACE IS NEEDED, USE BACK

If well telescopes please sketch and show depths.

GROUND LEVEL

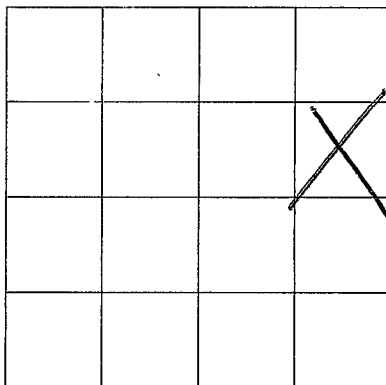

SECTION _____

Please indicate well location X.

ADDITIONAL INFORMATION

If more than one screen,
show location of each on sketch.