

E 1
5-2-66

WATER WELL DRILLERS LOG

CODED

Date: 5-2, 1966, Driller: E.B. SHERRARD County: MARION
(Name)

- (1) Owner of Land: RICHARD M. REID
(Name)
Columbia, Miss.
(Address)
- (2) Location: 1/4, 1/4, Sec. 30 T. 4 N. R. 12
(distance) (direction) (Nearest Town) RISE
- (3) Topography: (Hilly) (Flat) (Level)
- (4) Purpose of Well: DOMESTIC
(Domestic Irrigation
Municipal, Industrial, Other)

Description & Color of Materials Sand, Clay, Red Clay, Shell, etc.	Thick- ness Feet	Dep Fe
<u>HARD RED CLAY</u>	<u>40</u>	
<u>SAND & GRAVEL</u>	<u>55</u>	
<u>RED CLAY</u>	<u>60</u>	
<u>GRAY & RED CLAY WITH</u>	<u>"</u>	
<u>INCONSISTENT LAYERING OF</u>	<u>"</u>	
<u>SAND & FINE SAND</u>	<u>130</u>	
<u>SANDY CLAY</u>	<u>140</u>	
<u>CAVITY</u>	<u>145</u>	


Information upon completion of well:

- (1) Diameter 2 inches.
- (2) Total Depth 145 feet.
- (3) Water Level 40 feet below top of ground.
- (4) Cased to 145, Size 2"
- (5) Screen: Size 2", Length 3'
- (6) Were any formations sealed against pollution?
no

If YES depth of formation _____

Why _____

Drillers Remarks: _____

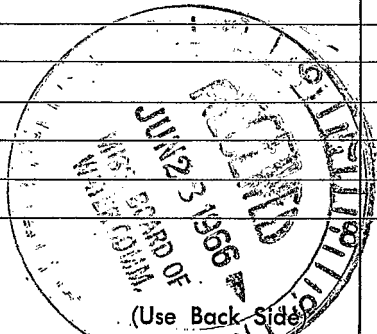

Well No.

