

Marion
E 2
11-66

Dean Griner Plumbing & Well Service

WATER WELL DRILLERS LOG

Date: 11/5, 1966, Driller: Jimmy Powell County: Marion
(Name)

- (1) Owner of Land: Nooley Morgan
(Name)
Rt. 1 Foxworth, Miss.
(Address)
- (2) Location: NE 1/4, SE 1/4, Sec. 3 T4N R12E
8 miles N, of Mountain
(distance) (direction) (Nearest Town)
- (3) Topography: X
(Hilly) (Flat) (Level)
- (4) Purpose of Well: water well
(Domestic Irrigation
Municipal, Industrial, Other)


Description & Color of Materials Sand, Clay, Red Clay, Shell, etc.	Thick- ness Feet	Depth Feet
Top soil Sand & gravel	4 142	4 146

CODED

Information upon completion of well:

- (1) Diameter 4 1/2 inches.
- (2) Total Depth 146 feet.
- (3) Water Level 116 feet below top of ground.
- (4) Cased to 140, Size 2
- (5) Screen: Size 2, Length 4
- (6) Were any formations sealed against pollution?
yes, X no.

If YES, depth of formation _____
Why _____
Drillers Remarks: _____

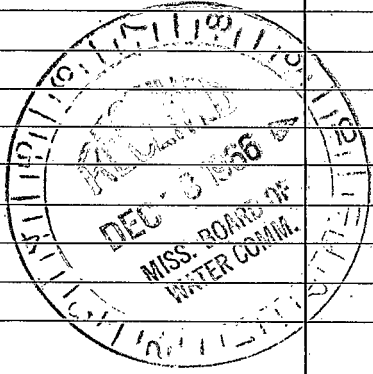

(Use Back Side)

Well No.

