

Marion  
 E 4  
 1-68

MISSISSIPPI  
 BOARD OF WATER COMMISSIONERS  
 416 North State Street  
 Jackson, Mississippi 39201

WATER WELL DRILLERS LOG

COBEL

1-31  
 date well completed

1968 Fitzgerald Water Well Marion  
 firm name county well located

LANDOWNER: Morgan  
 Koko Road Rt Miss

(mailing address)  
 WELL LOCATION:  
 sec. 15 T 4 N R 20 E  
 14 miles NW of Columbia  
 (distance) (direction) (nearest town)

description of formations encountered	from		to	
Top Soil & clay	0	6		
Sand	6	128		
pg gravel	128	131		
Fine Sand	131	145		
pg gravel	145	160		


WELL PURPOSE: home  
 (home, irrigation, municipal, industrial)

WELL COMPLETION DATA:

(1) diameter (inches) 4  
 (2) total depth (feet) 157  
 (3) static water level (feet) 90 below above top of ground.  
 (4) casing plastic 157 (material) (depth)  
 4 (size) if telescope see back.  
 (5) screen 6' 157 (length) (depth to top)  
 4 plastic sch 40 (size) (material)  
 (6) pump 10 (HP) (yield gpm).  
 Elec (type power)  
 (7) electric log No (yes or no)


(organization running log)  
 (8) how well bottom plugged Well peg

DRILLERS REMARKS:

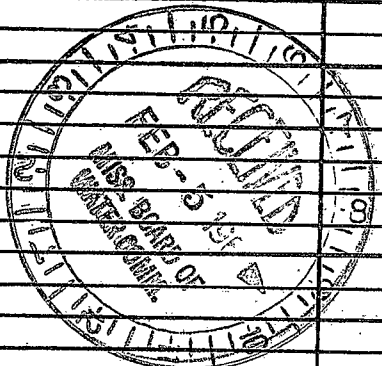

If well telescopes please sketch and show depths.

GROUND LEVEL

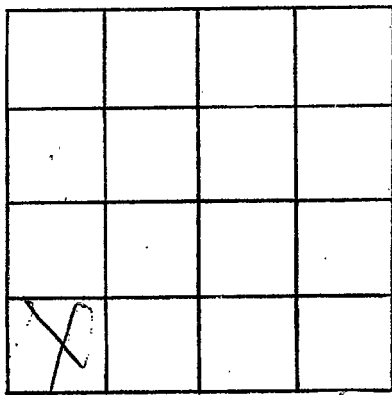

SECTION 14

Please indicate well location X

ADDITIONAL INFORMATION

If more than one screen,  
show locations of each on sketch.