




If well telescopes please sketch and show depths.

GROUND LEVEL

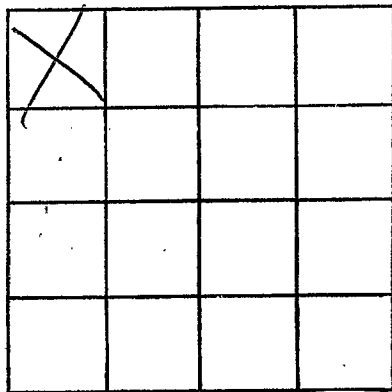

SECTION

29

Please indicate well location X.

ADDITIONAL INFORMATION

If more than one screen, show locations of each on sketch.