

Marion
 EL
 2-68

MISSISSIPPI
 BOARD OF WATER COMMISSIONERS
 416 North State Street
 Jackson, Mississippi 39201

CODED

WATER WELL DRILLERS LOG

2-1-68 date well completed
 68 Fitzgerald Water Well Service firm name
 Marion county well located

LANDOWNER: Wenford Williams
To home Rt MISS
 (mailing address)

description of formations encountered	from	to
Top soil & Clay	0	18
Sand	18	36
Gravel	36	68
Sand Fine	68	125
Sand medium	125	142
Gravel	142	165


WELL LOCATION:
 sec. 15 T 4 N R 20 E
10 miles NW of Columbia
 (distance) (direction) (nearest town)

WELL PURPOSE: home
 (home, irrigation, municipal, industrial)

WELL COMPLETION DATA:

- (1) diameter (inches) 4
- (2) total depth (feet) 165
- (3) static water level (feet) 130 below/above top of ground.
- (4) casing plastic 124
 (material) (depth)
4 if telescope see back.
 (size)
- (5) screen 61 124
 (length) (depth to top)
4 Sch 40
 (size) (material)
- (6) pump Sublv 10
 (HP) (yield gpm)
3hp
 (type power)
- (7) electric log no
 (yes or no)
 (organization running log)
- (8) how well bottom plugged wood peg


CODED

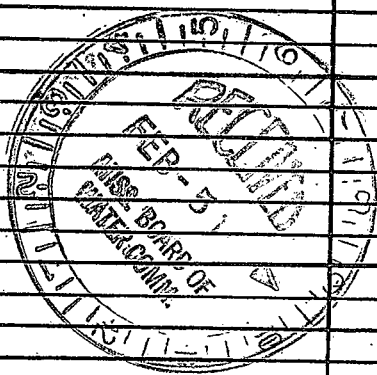

DRILLERS REMARKS:

If well telescopes please sketch and show depths.

GROUND LEVEL

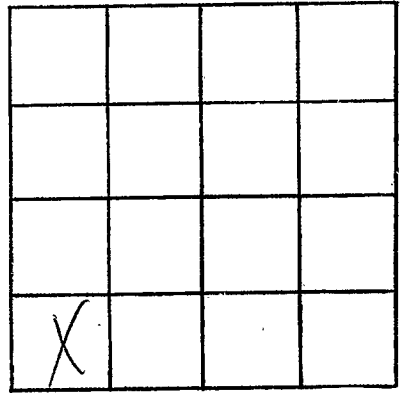

SECTION B¹

Please indicate well location X.

ADDITIONAL INFORMATION

If more than one screen,
show locations of each on sketch.