

CODED

MISSISSIPPI
BOARD OF WATER COMMISSIONERS
416 North State Street
Jackson, Mississippi 39201

WATER WELL DRILLERS LOG

MARION
E 1
4-68

April 9 1968 *Fort Lauderdale Inc* Marion
date well completed firm name county well located

LANDOWNER: *James Ratchiff*
RR, Fortworth Miss
(mailing address)

WELL LOCATION:
sec. 22 T 4 N R 12 E
10 miles NW of *Fortworth*
(distance) (direction) (nearest town)

WELL PURPOSE: *Home*
(home, irrigation, municipal, industrial)

- WELL COMPLETION DATA:
- (1) diameter (inches) 4"
 - (2) total depth (feet) 160'
 - (3) static water level (feet) 135' below top of ground
 - (4) casing Plastic 154'
(material) (depth)
4" if telescope see back.
(size)
 - (5) screen 6', 154'
(length) (depth to top)
4", Plastic
(size) (material)
 - (6) pump 7 1
(HP) (yield gpm)
Chc
(type power)
 - (7) electric log no
(yes or no)
 - (organization running log)
 - (8) how well bottom plugged used gun

description of formations encountered	from	to
<i>Red clay</i>	0	30
<i>Red gravel</i>	30	75
<i>Red sand</i>	75	105
<i>Red gravel</i>	105	130
<i>Red sand</i>	130	140
<i>Coarse sand's gravel</i>	140	160

CODED


APR 26 1968

MISS. Bd. OF
WATER COMM.

DRILLERS REMARKS:

If well telescopes please sketch and show depths.

GROUND LEVEL

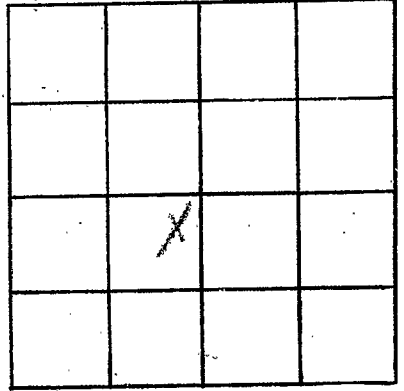

SECTION 22

Please indicate well location X.

ADDITIONAL INFORMATION

If more than one screen, show locations of each on sketch.