

MARION
E 8
2-68

MISSISSIPPI
BOARD OF WATER COMMISSIONERS CODED
416 North State Street
Jackson, Mississippi 39201

WATER WELL DRILLERS LOG

2-2 1968 Fitzgerald Water Well Marion
date well completed firm name county well located

LANDOWNER: M.T. Sinai
Morgan town RAMISS
(mailing address)


description of formations encountered	from	to
<u>Top soil + Red clay</u>	<u>0</u>	<u>12</u>
<u>Red sand</u>	<u>12</u>	<u>18</u>
<u>Gravel Sand</u>	<u>18</u>	<u>110</u>
<u>Gravel Sand</u>	<u>110</u>	<u>148</u>

WELL LOCATION:
sec. 19 T. 4 N. R. 12 E.
13 miles W N W of Polk
(distance) (direction) (nearest town)

WELL PURPOSE: home
(home, irrigation, municipal, industrial)


- WELL COMPLETION DATA:
- (1) diameter (inches) 4
 - (2) total depth (feet) 148
 - (3) static water level (feet) 130 below above top of ground.
 - (4) casing plastic (material) 142 (depth)
4 (size) if telescope see back.
 - (5) screen 6' (length) 142 (depth to top)
4 (size) Sch 40 (material)
 - (6) pump Elec (HP) - (yield gpm)
(type power)
 - (7) electric log no (yes or no)
(organization running log)
 - (8) how well bottom plugged Weld pipe

DRILLERS REMARKS:

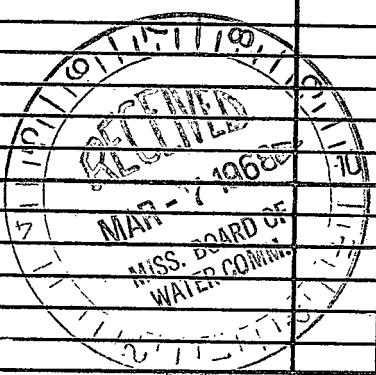

If well telescopes please sketch and show depths.

GROUND LEVEL

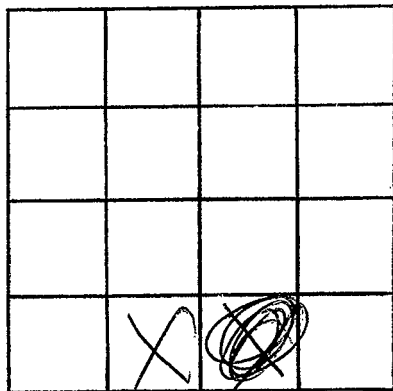

SECTION 19

Please indicate well location X.

ADDITIONAL INFORMATION

If more than one screen,
show locations of each on sketch.