

CODED

MISSISSIPPI  
BOARD OF WATER COMMISSIONERS  
416 North State Street  
Jackson, Mississippi 39201

WATER WELL DRILLERS LOG

*Marion*  
*E 9*  
*7-68*

*7-7* 19*68* *Recurrent Fair* *Marion*  
date well completed firm name county well located

LANDOWNER: *Benny Damman*  
*Rt 1 Koboans, Miss.*

description of formations encountered	from	to
<i>Clay</i>	<i>0</i>	<i>64</i>
<i>sand &amp; pea gravel</i>	<i>64</i>	<i>89</i>

(mailing address)


WELL LOCATION:  
sec. *17* T *4* N R. *12* E  
*9* miles *N* of *Koboans*  
(distance) (direction) (nearest town)

CODED

WELL PURPOSE: *home*  
(home, irrigation, municipal, industrial)

WELL COMPLETION DATA:

- (1) diameter (inches) *2"*
- (2) total depth (feet) *89'*
- (3) static water level (feet) *25'*  below  above top of ground.
- (4) casing *2" gal.* *86'*  
(material) (depth)  
\_\_\_\_ if telescope see back.  
(size)
- (5) screen *3'* *86'*  
(length) (depth to top)  
*.008* *Stainless steel*  
(size) (material)
- (6) pump *1* \_\_\_\_\_  
(HP) (yield gpm)  
*Elect*  
(type power)
- (7) electric log *no*  
(yes or no)  
\_\_\_\_\_  
(organization running log)
- (8) how well bottom plugged *Back*  
*Wash Water*

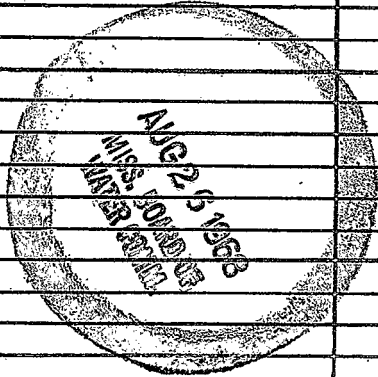

DRILLERS REMARKS:

If well telescopes please  
sketch and show depths.

GROUND LEVEL


SECTION \_\_\_\_\_

Please indicate well location X.

ADDITIONAL INFORMATION

If more than one screen,  
show locations of each on sketch.